

LOWDES
N 2012

**MISSISSIPPI
BOARD OF WATER COMMISSIONERS**
416 North State Street
Jackson, Mississippi 39201

WATER WELL DRILLERS LOG

4/21 1978 WALKSAP Drilling Inc. LOWDES
 date well completed firm name county well located

LANDOWNER: Mr. William Ash
Rt. 1 Box 280
Crawford, MS. 39743
 (mailing address)

description of formations encountered	from	to
Top Soil	0	10
Limes Rock	10	260
1 st SAND	260	300
MUCK	300	340
2 nd SAND	340	500

WELL LOCATION:
 sec. 13 T. 17 N R. 16 E
5 miles N.E. of Crawford
 (distance) (direction) (nearest town)

WELL PURPOSE: None
 (home, irrigation, municipal, industrial)

WELL COMPLETION DATA:

(1) diameter (inches) 4" x 9"

(2) total depth (feet) 500'

(3) static water level (feet) 70 below top of ground.

(4) casing 4" plastic, 26'
 (material) (depth)
2"
 (size) If telescope see back.


(5) screen 80', 420'
 (length) (depth to top)
2", plastic
 (size) (material)

(6) pump 1/2, 9
 (HP) (yield gpm)
Electric
 (type power)

(7) electric log NO
 (yes or no)

(8) how well bottom plugged CAP
 (organization running log)

DRILLERS REMARKS:

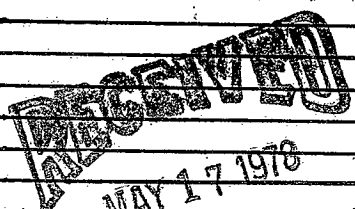


MAY 17 1978

MISS. BD. OF WATER COMM

If well telescopes please sketch and show depths.

GROUND LEVEL

26'
4"
Casing

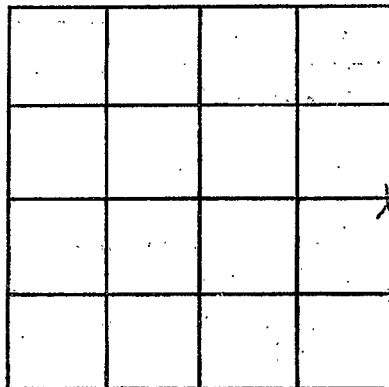

SECTION 13

Please indicate well location X.

ADDITIONAL INFORMATION

200'
2"
Casing

80'
C.
Screens

If more than one screen, show locations of each on sketch.