

LOWDES
N
2013

MISSISSIPPI  
 BOARD OF WATER COMMISSIONERS  
 416 North State Street  
 Jackson, Mississippi 39201

WATER WELL DRILLERS LOG

MAY 5 1978 ALLsup Drilling INC Lowndes  
 date well completed firm name county well located

LANDOWNER: SA Matthew  
 Baptist Church  
 c/o Mr. Tommie Lee R. NINE  
 Rt 3 Box 278  
 Columbus, MS. 39701  
 (mailing address)

description of formations encountered	from	to
CLAY	0	10
LIME Rock	10	440
1st SAND	440	485
Muck	485	525
2nd SAND	525	602

WELL LOCATION:  
 sec 2 T 17 N R 16 E  
 3 1/2 miles SW of Artesia  
 (distance) (direction) (nearest town)

WELL PURPOSE: Church  
 (home, irrigation, municipal, industrial)

WELL COMPLETION DATA:

- (1) diameter (inches) 4" X 2"
- (2) total depth (feet) 602'
- (3) static water level (feet) 100' below top of ground.
- (4) casing plastic 26' (material) (depth)  
 2" if telescope see back.  
 (size)
- (5) screen 80' 522' (length) (depth to top)  
 1/2" plastic (size) (material)
- (6) pump 1/2 HP 9 (yield gpm)  
 Electric (type power)
- (7) electric log NO (yes or no)

(organization running log)

(8) how well bottom plugged cap

DRILLERS REMARKS:


RECEIVED  
 MAY 24 1978

MISS. BD. OF WATER COMMISSIONERS

If well telescopes please sketch and show depths.

GROUND LEVEL

26'  
4" casing

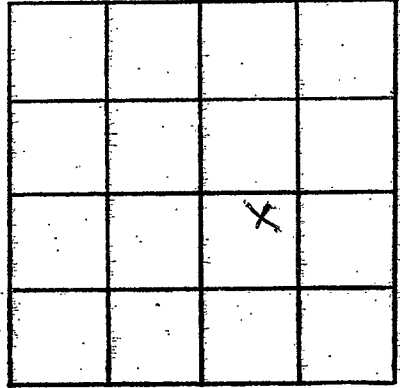

SECTION 2

Please indicate well location X.

ADDITIONAL INFORMATION

200'  
2"  
Casing  
80'  
C.  
Screen

If more than one screen, show locations of each on sketch.