

LOWNDES

N 2014

5/5/78

5/5 date well completed

MISSISSIPPI BOARD OF WATER COMMISSIONERS 416 North State Street Jackson, Mississippi 39201

WATER WELL DRILLERS LOG

1978 Ahhsup Drilling INC. firm name

LOWNDES county well located

LANDOWNER: Mr. Joe Hill P.O. Box 51 Crawford, MS, 39443 (mailing address)

description of formations encountered	from	to
	top soil	0
lime rocks	6	706
1st sand	706	756
muck	756	806
2nd sand	806	900

WELL LOCATION: sec. 35 T 17 N R 16 E S W 1 mile W of Crawford (distance) (direction) (nearest town)

WELL PURPOSE: (home, irrigation, municipal, industrial)

- WELL COMPLETION DATA:
- (1) diameter (inches) 4" x 2"
  - (2) total depth (feet) 900'
  - (3) static water level (feet) 130' below top of ground
  - (4) casing 4" plastic, 30' (material) (depth) 4" x 2" if telescope see back (size)
  - (5) screen 80' length, 820' depth to top (size) (material) plastic
  - (6) pump 1 HP, 15 (yield gpm) (type power) Electric
  - (7) electric log NO (yes or no)

(organization running log) CAP (8) how well bottom plugged

DRILLERS REMARKS:

DEPT. OF NATURAL RESOURCES BUREAU OF LAND & WATER RESOURCES


AUG 8 1980

RECEIVED

If well telescopes please sketch and show depths.

GROUND LEVEL

30' 4"  
Casing

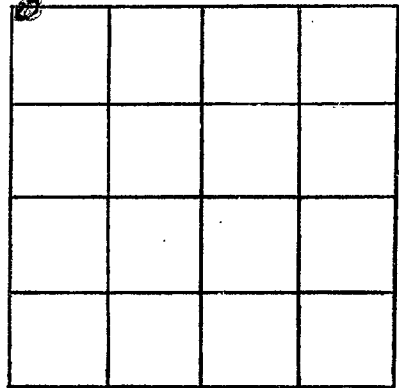

SECTION 32

Please indicate well location X.

ADDITIONAL INFORMATION

240' 2"  
Casing

80' 2"  
Commercial  
Screen

If more than one screen,  
show locations of each on sketch.