

LOWNDES
 N 2000
 6/16/79

MISSISSIPPI
 BOARD OF WATER COMMISSIONERS
 416 North State Street.
 Jackson, Mississippi 39201

WATER WELL DRILLERS LOG

6/16 1979 Alih. Sup Drilling Inc LOWNDES
 date well completed firm name county well located

LANDOWNER: Mr. Mose Harris
 Rt. 1, Box 259
 Crawford, Ms. 39743
 (mailing address)

description of formations encountered	from	to
Top Soil	0	8
Shale Rock	8	500
Sand	500	560
Muck	560	600
2 1/2 Sand	600	750

WELL LOCATION:
 sec. 8 T 17 N R 16 E
 4 1/2 miles NW of Crawford
 (distance) (direction) (nearest town)

WELL PURPOSE: home
 (home, irrigation, municipal, industrial)

WELL COMPLETION DATA:

(1) diameter (inches) 4" x 2"
 (2) total depth (feet) 750
 (3) static water level (feet) 130' below top of ground.
 (4) 4" casing plastic, 26' (material) (depth)
 4" x 2" (size) if telescope see back.
 (5) screen 80' length, 670' depth to top
 4" x 2" plastic (size) (material)
 (6) pump 1/2 (HP) 10 (yield gpm)
 Electric (type power)
 (7) electric log NO (yes or no)
 (organization running log)
 (8) how well bottom plugged Cap

Miss. Board of Water Comm.


AUG 22 1979

RECEIVED

DRILLERS REMARKS:


If well telescopes please sketch and show depths.

GROUND LEVEL

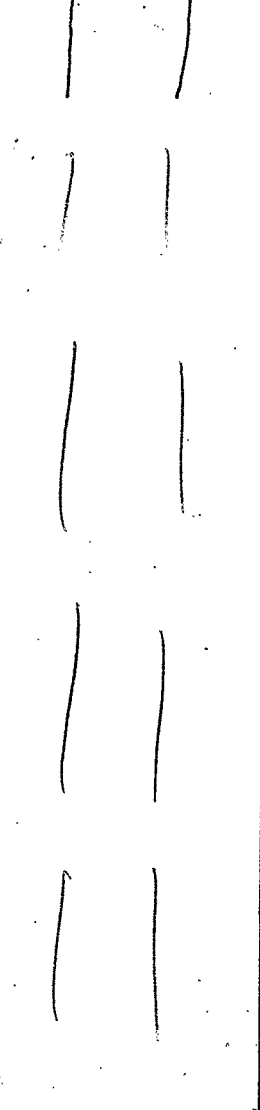

26'
4" Casing

200' 2"
Casing
80' 2"
Commercial
Screen

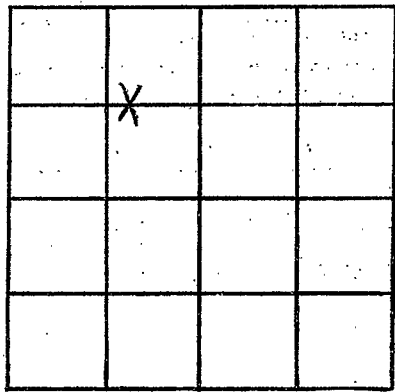

SECTION 8

Please indicate well location X.

ADDITIONAL INFORMATION

A series of horizontal lines provided for additional information.

If more than one screen, show locations of each on sketch.