

Lowndes
N2021
8-11-79

MISSISSIPPI
 BOARD OF WATER COMMISSIONERS
 416 North State Street
 Jackson, Mississippi 39201

WATER WELL DRILLERS LOG

8/11 1979 ALBSUD Drilling INC Lowndes
 date well completed firm name county well located

LANDOWNER: Bud Holtcamp
RR 1
Crawford Ms. 39443
 (mailing address)

description of formations encountered	from	to
<u>TOP SOIL</u>	<u>0</u>	<u>30</u>
<u>3rd SAND</u>	<u>30</u>	<u>32</u>
<u>limb. Rock</u>	<u>32</u>	<u>472</u>
<u>1st SAND</u>	<u>472</u>	<u>882</u>
<u>2nd SAND</u>	<u>882</u>	<u>999'</u>

WELL LOCATION:
 sec. 1 T 17 N R 16 E
S 1/2 miles NW of Crawford
 (distance) (direction) (nearest town)

WELL PURPOSE: home
 (home, irrigation, municipal, industrial)

WELL COMPLETION DATA:
 (1) diameter (inches) 4" X 2"
 (2) total depth (feet) 999'
 (3) static water level (feet) 60 below top of ground.
 (4) casing (material) plastic, (depth) 26'
4" X 2" If telescope see back.
 (5) screen 80', (length) 919', (depth to top)
4" X 2", (size) plastic, (material)
 (6) pump 1/2, (HP) 9, (yield gpm)
Electric
 (type power)
 (7) electric log NO
 (yes or no)
 (organization running log) CAN
 (8) how well bottom plugged CAN

DRILLERS REMARKS:


DEPT. OF NATURAL RESOURCES
 BUREAU OF LAND & WATER RESOURCES

OCT 16 1979
 RECEIVED

If well telescopes please sketch and show depths.

GROUND LEVEL

40' 4"
Casing

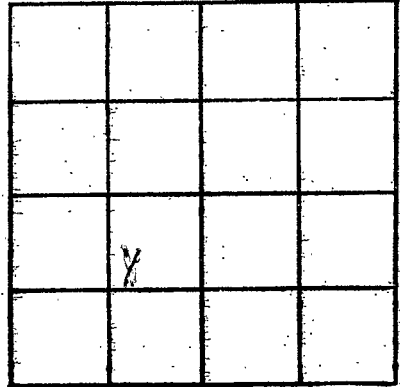

SECTION 1

Please indicate well location X.

ADDITIONAL INFORMATION

200'
2" Casing

80' 2"
Commercial
Screens

If more than one screen,
show locations of each on sketch.