

Lowndes
N 203

MISSISSIPPI
BOARD OF WATER COMMISSIONERS
416 North State Street
Jackson, Mississippi 39201

7-10-79

WATER WELL DRILLERS LOG

7/10 date well completed 1979 ALKSHD Drilling Inc. firm name Lowndes county well located

LANDOWNER: Henry L. Greer
Rt. 1 Box 256
Crawford, MS.
(mailing address)

description of formations encountered	from	to
Top Soil	0	9
CLAY	9	20
Lime Rock (blue)	20	28
White Rock	28	516
1st SAND	516	522
Muck	522	536
2nd SAND	536	650

WELL LOCATION:
sec. 8 T 17 N R 16 E
4 miles NW of Crawford
(distance) (direction) (nearest town)

WELL PURPOSE: home
(home, irrigation, municipal, industrial)

WELL COMPLETION DATA:
(1) diameter (inches) 4" X 2"
(2) total depth (feet) 650'
(3) static water level (feet) 130' below top-of-ground
(4) casing 4" plastic (material) 26' (depth)
4" X 2" (size) if telescope see back.
(5) screen 80' (length) 570' (depth to top)
4" X 2" (size) plastic (material)
(6) pump 1/2 (HP) 10 (yield gpm)
Electric (type power)
(7) electric log NO (yes or no)

(organization running log)

(8) how well bottom plugged CAP

DRILLERS REMARKS:

DEPT. OF NATURAL RESOURCES
BUREAU OF LAND & WATER RESOURCES


OCT 11 1979

RECEIVED

If well telescopes please sketch and show depths.

GROUND LEVEL

26'
4" Casing

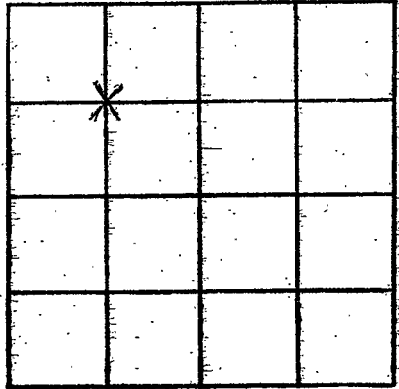

SECTION 8

Please indicate well location X.

ADDITIONAL INFORMATION

200'
2" Casing

80'
Commercial
Screen

If more than one screen, show locations of each on sketch.