

Loude
~~2024~~
 11-18-80
 N 2024

MISSISSIPPI
 BOARD OF WATER COMMISSIONERS
 416 North State Street
 Jackson, Mississippi 39201

WATER WELL DRILLERS LOG

11-18 1980 Abhsup Drilling Inc Loude's
 date well completed firm name county well located

LANDOWNER: Edmond Carter
RR 1 Box 265
Crawford MS. 39743
 (mailing address)

description of formations encountered	from	to
top soil	0	10
Lime Rock	10	450
SAND	450	490
Mud	490	530
2nd SAND	530	780

WELL LOCATION:
 sec. 9 T 17 N R 16 E
3 1/2 miles North of Crawford
 (distance) (direction) (nearest town)

WELL PURPOSE: home
 (home, irrigation, municipal, industrial)


- WELL COMPLETION DATA:
- diameter (inches) 4" x 2"
 - total depth (feet) 780'
 - static water level (feet) 90' below top of ground.
 - casing Plastic 30'
 (material) (depth)
4" x 2" If telescope see back.
 (size)
 - screen 80' 700'
 (length) (depth to top)
2" plastic
 (size) (material)
 - pump 1/2 Electric
 (HP) (yield gpm)
 (type power)
 - electric log NO
 (yes or no)
 (organization running log)
 - how well bottom plugged CAP



DRILLERS REMARKS:

If well telescopes please sketch and show depths.


GROUND LEVEL

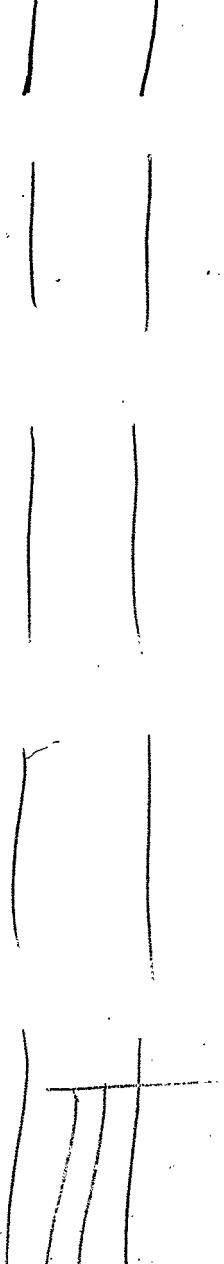

30'
4" Casing

200' 2"
Casing
30' 2"
Commercial
Screen

If more than one screen,
show locations of each on sketch.

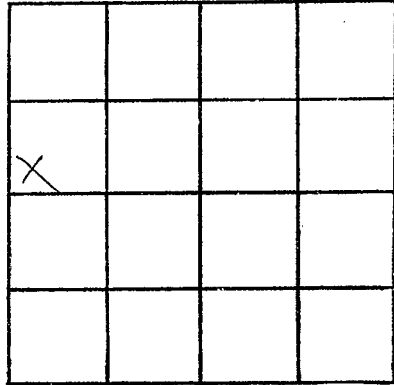

SECTION 9

Please indicate well location X.

ADDITIONAL INFORMATION

Lined area for additional information.