

LOWNDES
 N 2026
 8-10-81

MISSISSIPPI
 BOARD OF WATER COMMISSIONERS
 416 North State Street
 Jackson, Mississippi 39201

2

WATER WELL DRILLERS LOG


8-10 date well completed
 1981 Marvin S. Redwood firm name
 Lowndes county well located

LANDOWNER: J.C. Perry
 Crawford miss.
 (mailing address)
 WELL LOCATION:
 sec. 2 T. 17 N R. 16 E
 4 miles NORTH of CRAWFORD
 (distance) (direction) (nearest town)

WELL PURPOSE: Home
 (home, irrigation, municipal, industrial)

- WELL COMPLETION DATA:
- (1) diameter (inches) 4"
 - (2) total depth (feet) 500
 - (3) static water level (feet) 113 below top of ground
 - (4) casing P.V.C. 168 (material) (depth)
 4" if telescope see back. (size)
 - (5) screen (length) (depth to top)
 (size) (material)
 - (6) pump 1/2 (HP) 10 (yield gpm)
 E (type power)
 - (7) electric log (yes or no)
 (organization running log)
 - (8) how well bottom plugged open
 Male

description of formations encountered	from	to
Brown Clay	0	18
Blue Clay	18	379
sand	379	391
Rock streaks	391	402
sand	402	451
clay	451	455
sand	455	468
clay	468	480
sand	480	495
clay	495	500

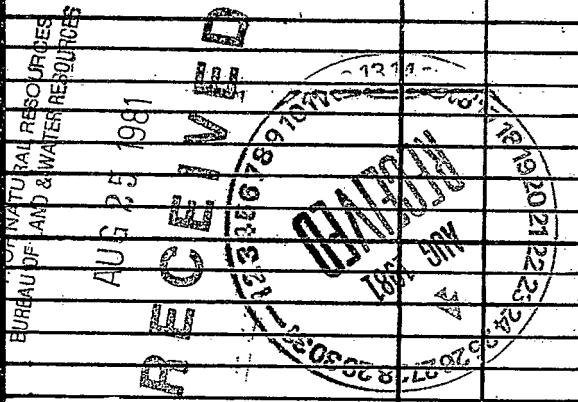

DRILLERS REMARKS:

