

Lowndes
N 2027

MISSISSIPPI
BOARD OF WATER COMMISSIONERS
416 North State Street
Jackson, Mississippi 39201

WATER WELL DRILLERS LOG

9/9 1982 Allsup Drilling, Inc. Lowndes
date well completed firm name county well located

LANDOWNER: Amelia Tolliver
RR 1, Box 255
Crawford, MS 39743
(mailing address)

description of formations encountered

from to

<u>CLAY</u>	<u>0'</u>	<u>10'</u>
<u>LIME ROCK</u>	<u>10'</u>	<u>490'</u>
<u>SAND</u>	<u>490'</u>	<u>540'</u>
<u>MUCK</u>	<u>540'</u>	<u>600'</u>
<u>SAND</u>	<u>600'</u>	<u>708'</u>

WELL LOCATION:

sec. 16 T. 17 N. R. 16 E.
1 3/4 miles N of CRAWFORD
(distance) (direction) (nearest town)

WELL PURPOSE: Home
(home, irrigation, municipal, industrial)

WELL COMPLETION DATA:

- (1) diameter (inches) 4"
- (2) total depth (feet) 700'
- (3) static water level (feet) 120' ~~above~~ below top of ground.
- (4) casing PVC 205'
(material) (depth)
4" x 2" if telescope see back,
(size) 620'
- (5) screen 80' 620'
(length) (depth to top)
2" PVC
(size) (material)
- (6) pump 3/4 15
(HP) (yield gpm)
Electric
(type power)
- (7) electric log NO
(yes or no)

(organization running log)

(8) how well bottom plugged capped

DRILLERS REMARKS:

DEPT. OF NATURAL RESOURCES
BUREAU OF LAND & WATER RESOURCES

OCT 14 1982

RECEIVED

If well telescopes please sketch and show depths.


GROUND LEVEL

4" CASING
25'

2" CASING
480' DIMEROD

200'-2"
CASING

2" SCREEN
80'

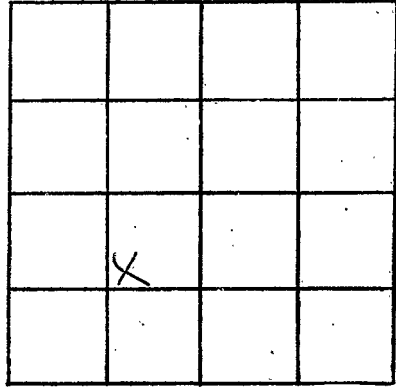

SECTION 11e

Please indicate well location X.

ADDITIONAL INFORMATION

If more than one screen, show locations of each on sketch.