

MISSISSIPPI DEPARTMENT OF NATURAL RESOURCES

Bureau of Land and Water Resources

Southport Mall

P.O. Box 10631

Jackson, Mississippi 39209

WATER WELL DRILLERS LOG

Lowndes
N 2030

March 1 19 82 Allsup Drilling, Inc. Lowndes
date well completed firm name county well located


LANDOWNER: Eugene Willis	description of formations encountered	from	to
RR 1, Box 240	Clay	0	5'
Crawford, MS 39743	Hard Lime Rock	5'	595'
(mailing address)	1st SAND	595'	635'
WELL LOCATION:	Muck	635'	685'
sec. <u>31</u> T. <u>17</u> N R. <u>16</u> E	SAND	685'	780'
<u>1 3/4</u> miles <u>W</u> of <u>CRAWFORD</u>			
(distance) (direction) (nearest town)			
WELL PURPOSE: Home (home, irrigation, municipal, industrial)			
WELL COMPLETION DATA:			
(1) diameter (inches) <u>4 3/8"</u>			
(2) total depth (feet) <u>780'</u>			
(3) static water level (feet) <u>100'</u> below top of ground.			
(4) casing <u>PVC</u> (material) (depth)			
<u>4" x 2"</u> if telescope see back. (size)			
(5) screen <u>80'</u> <u>700'</u> (length) (depth to top)			
<u>2"</u> <u>PVC</u> (size) (material)			
(6) pump <u>1</u> <u>15</u> (HP) (yield gpm)			
<u>Electric</u> (type power)			
(7) electric log <u>no</u> (yes or no)			
(organization running log)			
(8) how well bottom plugged <u>capped</u>			
DRILLERS REMARKS:			

DEPT. OF NATURAL RESOURCES
BUREAU OF LAND & WATER RESOURCES

DEC - 6 1982
RECEIVED

If well telescopes please sketch and show depths.

GROUND LEVEL

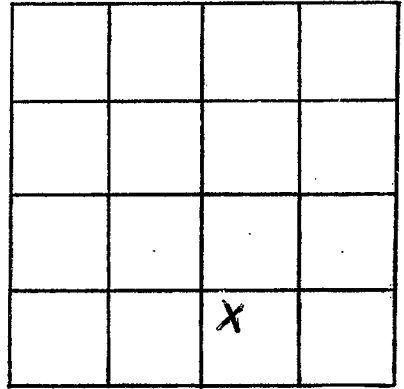

SECTION 31

Please indicate well location X.

ADDITIONAL INFORMATION

Lined area for additional information.

If more than one screen, show locations of each on sketch.