

N 2036

3-64

WATER WELL DRILLERS LOG

9

Date: March, 1964, Driller: Ever Drilling Co. County NOX
14528 14619 (Name)

(1) Owner of Land: Elbe Franklin
(Name)
Arteria Mues
(Address) 12 17 16E

(2) Location: 1/4, 1/4, Sec. L 17 R 6E
6 miles N.E., of Clayton
(distance) (direction) (Nearest Town)

(3) Topography: (Hilly) (Flat) (Level)

(4) Purpose of Well: Domestic
(Domestic Irrigation, Municipal, Industrial, Other)

| Description & Color of Materials Sand, Clay, Red Clay, Shell, etc. | Thick- ness Feet | Depth Feet |
|---|------------------------|---------------|
| <u>4" pipe black soil</u> | <u>21</u> | <u>21</u> |
| <u>Blue Rock</u> | <u>340</u> | <u>361</u> |
| <u>Blue sand</u> | <u>27</u> | <u>388</u> |
| <u>1 sand</u> | <u>40</u> | <u>428</u> |
| <u>rough mud</u> | <u>60</u> | <u>488</u> |
| <u>2 no sand</u> | <u>78</u> | <u>560</u> |
| | | <u>560</u> |

Information upon completion of well:

(1) Diameter 4 1/2 inches.

(2) Total Depth 560 feet.

(3) Water Level 75 feet below top of ground.

(4) Cased to 21, Size 4


(5) Screen: Size 2, Length 84

(6) Were any formations sealed against pollution?
 yes, no.

If YES depth of formation 21

Why Seal of surface was

Drillers Remarks:

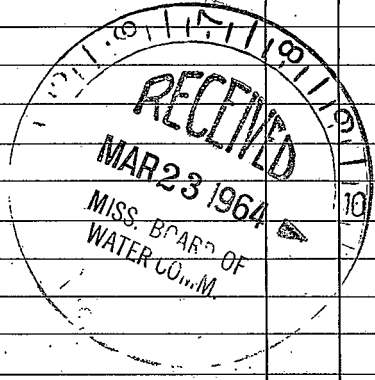

(Use Back Side)

Well No.

Handwritten scribble, possibly initials or a signature.

Handwritten scribble, possibly initials or a signature.

Handwritten scribble, possibly initials or a signature.