

N 2039
3-62

WATER WELL DRILLERS LOG

Date: Nov 1962, Driller: Loce Drilling Co County NOY
(Name)

(1) Owner of Land: Hutch Center
(Name)
Crawford Miss
(Address)

(2) Location: 1/4, 1/4, Sec 28 T17R16
miles of Crawford
(distance) (direction) (Nearest Town)

(3) Topography: _____
(Hilly) (Flat) (Level)

(4) Purpose of Well: Hutch Center
(Domestic Irrigation
Municipal, Industrial, Other)

Description & Color of Materials Sand, Clay, Red Clay, Shell, etc.	Thick- ness Feet	Depth Feet
<u>3 ft Clay</u>	<u>3</u>	<u>3</u>
<u>4" pip to 21</u>	<u>19</u>	<u>21</u>
<u>580 blue Rock</u>	<u>580</u>	<u>601</u>
<u>189 ft sand shale</u>	<u>189</u>	<u>790</u>
<u>140 ft shale</u>	<u>140</u>	<u>930</u>
<u>50 ft brown sand</u>	<u>50</u>	<u>980</u>

Information upon completion of well:

(1) Diameter 4 inches.

(2) Total Depth 980 feet.

(3) Water Level 130 feet below top of ground.


(4) Cased to Rock, Size 4"

(5) Screen: Size 2", Length 15

(6) Were any formations sealed against pollution?
X yes, _____ no.

If YES depth of formation Top soil 3'
Why keep out surface water

Drillers Remarks: _____

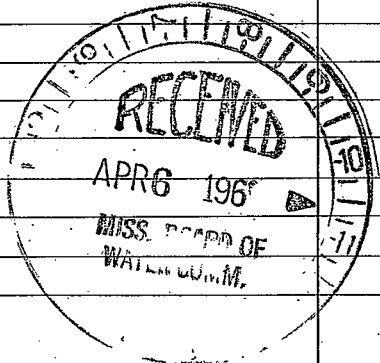

(Use Back Side)

Well No.

