

LOWNDES
φ
1-21-80

MISSISSIPPI
BOARD OF WATER COMMISSIONERS
416 North State Street
Jackson, Mississippi 39201

WATER WELL DRILLERS LOG

1-21 date well completed 80 MidSouth Drilling Co. firm name Louder county well located

LANDOWNER	description of formations encountered	from	to
<u>Heart Ridge Church</u> <u>Rt. 1 Box 75</u> <u>Columbus MS</u> (mailing address)	<u>clay</u>	<u>0</u>	<u>330</u>
WELL LOCATION: <u>sec 26 T 19 N R 12 E</u> <u>18 miles S of Col</u> (distance) (direction) (nearest town)	<u>clay & sand</u>	<u>330</u>	<u>390</u>
WELL PURPOSE: <u>home</u> (home, irrigation, municipal, industrial)	<u>clay</u>	<u>390</u>	<u>400</u>
WELL COMPLETION DATA: (1) diameter (inches) <u>4</u>	<u>clay & sand</u>	<u>400</u>	<u>570</u>
(2) total depth (feet) <u>570</u>	<u>clay & sand</u>	<u>570</u>	<u>585</u>
(3) static water level (feet) <u>80</u> below above top of ground.	<u>clay</u>	<u>585</u>	<u>600</u>
(4) casing <u>PVC</u> , <u>190</u> (material) (depth) <u>4</u> if telescope see back. (size)			
(5) screen <u>N/A</u> (length) (depth to top) (size) (material)			
(6) pump <u>1/2</u> <u>10</u> (HP) (yield gpm) <u>electric</u> (type power)			
(7) electric log <u>no</u> (yes or no) <u>no</u> (organization running log)			
(8) how well bottom plugged <u>open</u>			
DRILLERS REMARKS:			


DEPT OF NATURAL RESOURCES
BUREAU OF LAND & WATER RESOURCES

MAR 3 - 1980

RECEIVED

If well telescopes please
sketch and show depths.

GROUND LEVEL

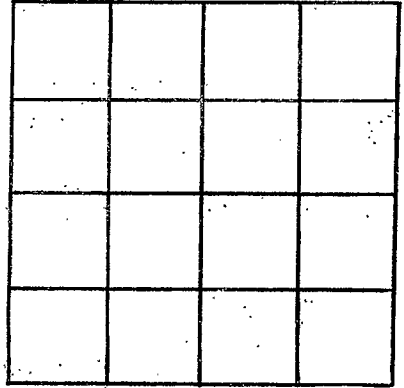

SECTION _____

Please indicate well location X.

ADDITIONAL INFORMATION

If more than one screen,
show locations of each on sketch.