

LOWNDES

~~Q~~

8/85

MISSISSIPPI
 BOARD OF WATER COMMISSIONERS
 416 North State Street
 Jackson, Mississippi 39201

make copy for Weyerhaeuser 8/23/85

WATER WELL DRILLERS LOG

date well completed 19 8/85 firm name Allsup Drilling, Inc. county well located LOWNDES

LANDOWNER: Weyerhaeuser (Daniel Construction Co.)
R.O. Box 1620
Columbus, MS 39701
 (mailing address)

description of formations encountered	from	to
Top Soil	0	35
Shale	35	125
Soft White Rock	125	300

WELL LOCATION:


sec. 11 T. 20 N. R. 17 E
 S W
8 miles S of Columbus
 (distance) (direction) (nearest town)

WELL PURPOSE: EDUCATIONAL
 (home, irrigation, municipal, industrial)
Development Center

WELL COMPLETION DATA:

- No. 2* Discharge Well
- (1) diameter (inches) 3"
 - (2) total depth (feet) 360
 - (3) static water level (feet) below above top of ground.
 - (4) casing (material) (depth) (size) if telescope see back.
 - (5) screen (length) (depth to top) (size) (material)
 - (6) pump (HP) (yield gpm) (type power)
 - (7) electric log NO (yes or no) (organization running log)
 - (8) how well bottom plugged OPEN

The Daniel Const. men gave us the requirements for this discharge well - they should have let us contact National Water Well Association and ~~International Association of Drilling Engineers~~ for recommendations.

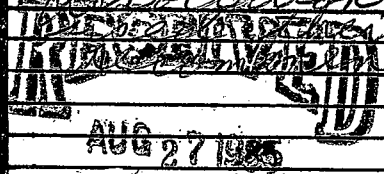


DRILLERS REMARKS:

This is discharge well for Heathorn system in E.H.C. Building

If well telescopes please sketch and show depths.

9

GROUND LEVEL

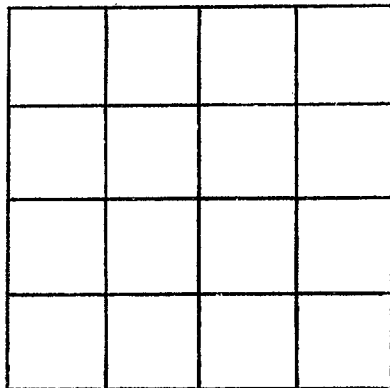

SECTION 11

Please indicate well location X.

ADDITIONAL INFORMATION

Lined area for providing additional information.

If more than one screen, show locations of each on sketch.