

Lowndes
Ø 23
6-15-70

MISSISSIPPI
 BOARD OF WATER COMMISSIONERS
 416 North State Street
 Jackson, Mississippi 39201

CODED

WATER WELL DRILLERS LOG

6-15 1970 ANTHONY Drilling Co Lowndes
 date well completed firm name county well located

LANDOWNER: Tarleton
John Tarleton
~~Crawford~~ Crawford, Miss.
 (mailing address)

| description of formations encountered | from | to |
|---------------------------------------|-------------|-------------|
| | | |
| <u>clay</u> | <u>0'</u> | <u>6'</u> |
| <u>white chalk</u> | <u>6'</u> | <u>510'</u> |
| <u>sand & Rocks</u> | <u>510'</u> | <u>730'</u> |

WELL LOCATION:
 sec. 31 T. 17 N. R. 17 E.
5 miles E of Crawford
 (distance) (direction) (nearest town)

WELL PURPOSE: Livestock
 (home, irrigation, municipal, industrial)

WELL COMPLETION DATA:

- (1) diameter (inches) 4"
- (2) total depth (feet) 730
- (3) static water level (feet) 70 below top of ground.
- (4) casing iron 250'
 (material) (depth)
4x2 if telescope see back.
 (size)
- (5) screen 84' perforated blk.
 (length) (depth to top)
2" iron
 (size) (material)
- (6) pump 1 5
 (HP) (yield gpm)
Elect.
 (type power)
- (7) electric log no
 (yes or no)
 (organization running log)
- (8) how well bottom plugged pipe
split & closed

CODED

JUL 13 1970

MISS. BD. OF
 WATER COMM.

DRILLERS REMARKS:


If well telescopes please sketch and show depths.

GROUND LEVEL

21' 4" pipe
↓

Open

7 3/8" casing

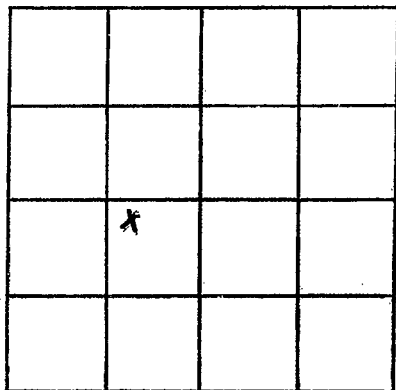

SECTION 31

Please indicate well location X.

ADDITIONAL INFORMATION

If more than one screen, show locations of each on sketch.