

Lourdes  
 0025  
 7-5-68

MISSISSIPPI  
 BOARD OF WATER COMMISSIONERS  
 416 North State Street  
 Jackson, Mississippi 39201

CODED  
**CODED**

WATER WELL DRILLERS LOG

7-5 1968 E. B. Woodward Lourdes  
 date well completed firm name county well located

LANDOWNER Tracy Anthony  
Crawford, Miss.

description of formations encountered	from	to
	Clay	0
Blue sand	18	208
Sand	208	214
Shale	214	318
Sand	318	320
Shale	330	361
Sand	361	373
Shale	373	414
Sand	414	430
Shale	430	434
Sand	434	477
Shale	477	507
Sand	507	515
Shale	515	560
Sand	560	574

(mailing address)

WELL LOCATION: 17  
 sec. 9 T. 17 N. R. 10 E.  
 S W  
 8 miles E of Crawford  
 (distance) (direction) (nearest town)

WELL PURPOSE:  
 (home, irrigation, municipal, industrial)

WELL COMPLETION DATA:

- diameter (inches) 4"
- total depth (feet) 574
- static water level (feet) 21' below top of ground.
- casing black pipe (material) 700' (depth)  
4" (size) if telescope see back.
- screen 400' (length) 400' (depth to top)  
2" (size) black pipe (material)
- pump HCM 50 (HP) 5 gal. (yield gpm)  
electric (type power)
- electric log no (yes or no)  
 (organization running log)
- how well bottom plugged cased

DRILLERS REMARKS:

CODED

**CODED**


FEB 19 1968  
 MISS. Bd. OF  
 WATER COMMISSIONERS

FEB 19 1968

MISS. Bd. OF  
 WATER COMMISSIONERS

If well telescopes please sketch and show depths.

GROUND LEVEL

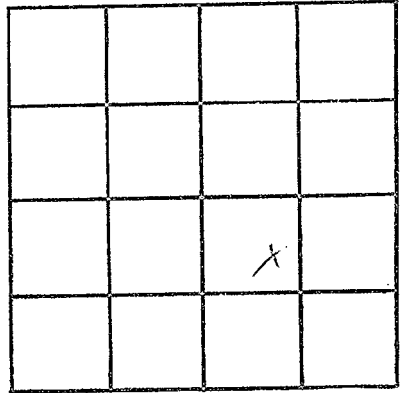

SECTION 97

Please indicate well location X.

ADDITIONAL INFORMATION

A series of horizontal lines for writing additional information, starting below the 'ADDITIONAL INFORMATION' header and extending to the bottom of the page.

If more than one screen, show locations of each on sketch.