

**LOWNDES**  
**Ø 27**  
**9-14-72**

MISSISSIPPI  
 BOARD OF WATER COMMISSIONERS  
 416 North State Street  
 Jackson, Mississippi 39201  
**WATER WELL DRILLERS LOG**

**CODED**

9-14 1972 ALLSUP DRILLING CO. Lowndes  
 date well completed firm name county well located

LANDOWNER:	description of formations encountered	from	to
<i>Ethel Hariston</i>			
(mailing address)	<i>Top Soil</i>	<i>0</i>	<i>17</i>
WELL LOCATION: sec. <i>33</i> T. <del>20</del> R. <i>17</i> E. S. <i>17</i> N. # <i>6</i> miles <i>E</i> of <i>Bayou</i>	<i>Blue Rock</i>	<i>17</i>	<i>409</i>
(distance) (direction) (nearest town)	<i>Sand</i>	<i>409</i>	<i>472</i>
WELL PURPOSE: (home, irrigation, municipal, industrial)	<i>Muck</i>	<i>472</i>	<i>507</i>
WELL COMPLETION DATA:			
(1) diameter (inches) <i>4" x 2"</i>			
(2) total depth (feet) <i>618</i>			
(3) static water level (feet) <i>71</i> below above top of ground.			
(4) casing <i>Plastic 20'</i> (material) (depth) <i>4"</i> (size) if telescope see back.			
(5) screen <i>60'</i> (length) <i>558'</i> (depth to top)			
(6) pump <i>1/2</i> (HP) <i>7</i> (yield gpm) <i>Electric</i> (type power)			
(7) electric log <i>No</i> (yes or no)			
(organization running log)			
(8) how well bottom plugged <i>Cap</i>			
DRILLERS REMARKS:			

**CODED**

NOV 14 1972

MISS. BO. OF  
 WATER COMMISSIONERS

If well telescopes please sketch and show depths.

GROUND LEVEL


20' 4"  
Casing

348'

Blue Rock

190' 2"  
Casing

60'  
2' Screen

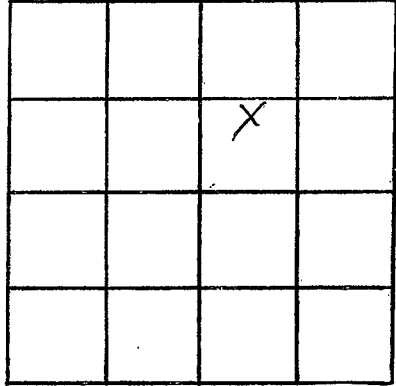

SECTION 3.3

Please indicate well location X.

ADDITIONAL INFORMATION

If more than one screen,  
show locations of each on sketch.