

LOWNDER

Ø 28

7-17-73

MISSISSIPPI
 BOARD OF WATER COMMISSIONERS
 416 North State Street
 Jackson, Mississippi 39201

CODED

WATER WELL DRILLERS LOG

July 17 1973 Norman E. Ehrhart Texemlar
 date well completed firm name county well located

LANDOWNER: EG. GARR	description of formations encountered	from	to
Brookville, Miss			
	Chalk	9	508
	Sand	508	628

(mailing address)

WELL LOCATION:
 sec. 32 T. 17 N. R. 17 E. S. W.
 5 miles EAST of Crawford
 (distance) (direction) (nearest town)

WELL PURPOSE: Home
 (home, irrigation, municipal, industrial)

CODED

WELL COMPLETION DATA:


- (1) diameter (inches) 5"
- (2) total depth (feet) 628
- (3) static water level (feet) 120 below above top of ground.
- (4) casing 2.1' Steel Casing (material) (depth)
 (size) If telescope see back.
- (5) screen Ø (length) (depth to top)
 (size) (material)
- (6) pump Ø (HP) (yield gpm)
 (type power)
- (7) electric log (yes or no)
 (organization running log)
- (8) how well bottom plugged

DRILLERS REMARKS:

JUL 30 1973

If well telescopes please sketch and show depths.

GROUND LEVEL

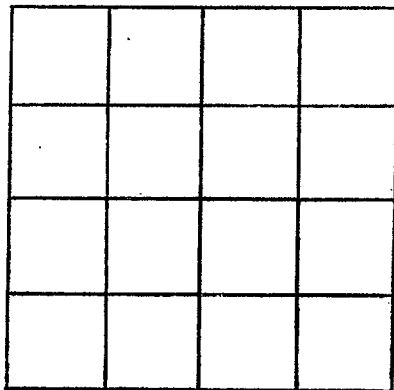

SECTION _____

Please indicate well location X.

ADDITIONAL INFORMATION

If more than one screen, show locations of each on sketch.