

LOWMEDES
 Ø 31
 1-3-75

MISSISSIPPI
 BOARD OF WATER COMMISSIONERS
 416 North State Street
 Jackson, Mississippi 39201

CODED

WATER WELL DRILLERS LOG

JAN 3 1975 ²⁵⁰ Allsup Drilling, Inc. Lowmes
 date well completed firm name county well located

LANDOWNER: <u>JAMES J. HAIRSTON</u>	description of formations encountered	from	to
<u>ROUTE</u>	<u>CLAY</u>	<u>0</u>	<u>10</u>
<u>CRAWFORD, MISS. 39749</u> (mailing address)	<u>BLUE ROCK</u>	<u>10</u>	<u>194</u>
<u>WELL LOCATION:</u>	<u>WHITE ROCK</u>	<u>194</u>	<u>458</u>
sec <u>30</u> T <u>17</u> N R <u>12</u> E	<u>SAND</u>	<u>458</u>	<u>464</u>
<u>3 1/2</u> miles <u>East</u> of <u>CRAWFORD</u>	<u>MUCK</u>	<u>464</u>	<u>514</u>
(distance) (direction) (nearest town)	<u>SAND</u>	<u>514</u>	<u>540</u>
<u>WELL PURPOSE: Home</u> (home, irrigation, municipal, industrial)	<u>MUCK</u>	<u>540</u>	<u>588</u>
<u>WELL COMPLETION DATA:</u>	<u>SAND</u>	<u>588</u>	<u>700</u>
(1) diameter (inches) <u>4" X 2"</u>			
(2) total depth (feet) <u>700'</u>			
(3) static water level (feet) <u>60'</u> below top of ground.			
(4) <u>PLASTIC</u> casing (material) <u>227'</u> (depth)			
<u>4" X 2"</u> (size) if telescope see back.			
(5) screen <u>80'</u> (length) <u>620'</u> (depth to top)			
<u>2"</u> (size) <u>PLASTIC</u> (material)			
(6) pump <u>1/2</u> (HP) <u>10</u> (yield gpm)			
<u>Electric</u> (type power)			
(7) electric log <u>NO</u> (yes or no)			
(organization running log)			
(8) how well bottom plugged <u>CAP</u>			
<u>DRILLERS REMARKS:</u>			

RECEIVED
 MAY 22 1975

If well telescopes please sketch and show depths.


GROUND LEVEL

Rock

27' 4"
Plastic
Casing

270' Plastic
2" Casing +
Screen

80' Screen

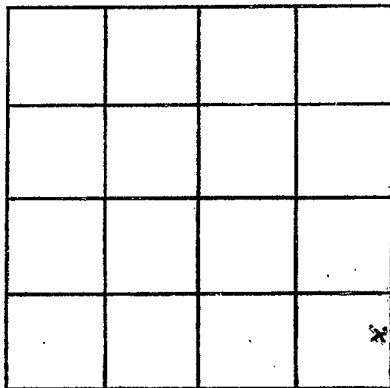

SECTION 30

Please indicate well location X.

ADDITIONAL INFORMATION

If more than one screen,
show locations of each on sketch.