

LOWNDES  
 32  
 12175

MISSISSIPPI  
 BOARD OF WATER COMMISSIONERS  
 416 North State Street  
 Jackson, Mississippi 39201

CODED

WATER WELL DRILLERS LOG

December 19 75 Herndon Well & Supply, Inc. Lowndes  
 date well completed firm name county well located

LANDOWNER: Deerbrook Corp.  
 Brooksville  
 Mississippi  
 (mailing address)

| description of formations encountered | from | to  |
|---------------------------------------|------|-----|
| Brown Clay                            | 0    | 22  |
| Blue Rock                             | 22   | 575 |
| Sand                                  | 575  | 610 |
| Blue Rock                             | 610  | 615 |
| Sand                                  | 615  | 640 |
| Blue Rock                             | 640  | 660 |

WELL LOCATION:  
 sec. 23 T. 17 N. R. 17 E  
 8 E / Brooksville  
 (distance) miles (direction) of (nearest town)

WELL PURPOSE: Farm  
 (home, irrigation, municipal, industrial)

CODED

WELL COMPLETION DATA:


(1) diameter (inches) 5 x 2½  
 (2) total depth (feet) 660  
 (3) static water level (feet) 56' below top of ground.  
 (4) casing steel 630 (material) (depth)  
 5 & 2½ (size) If telescope see back.  
 (5) screen 40 620 (length) (depth to top) *with screen*  
 2½" steel (size) (material)  
 (6) pump 3 30 (HP) (yield gpm)  
 Elec. (type power)  
 (7) electric log yes (yes or no)  
 USGS (organization running log)  
 (8) how well bottom plugged

RECEIVED  
 NOV 26 1978  
 MISS. Bd. OF WATER COMM

DRILLERS REMARKS:

If well telescopes please sketch and show depths.

GROUND LEVEL

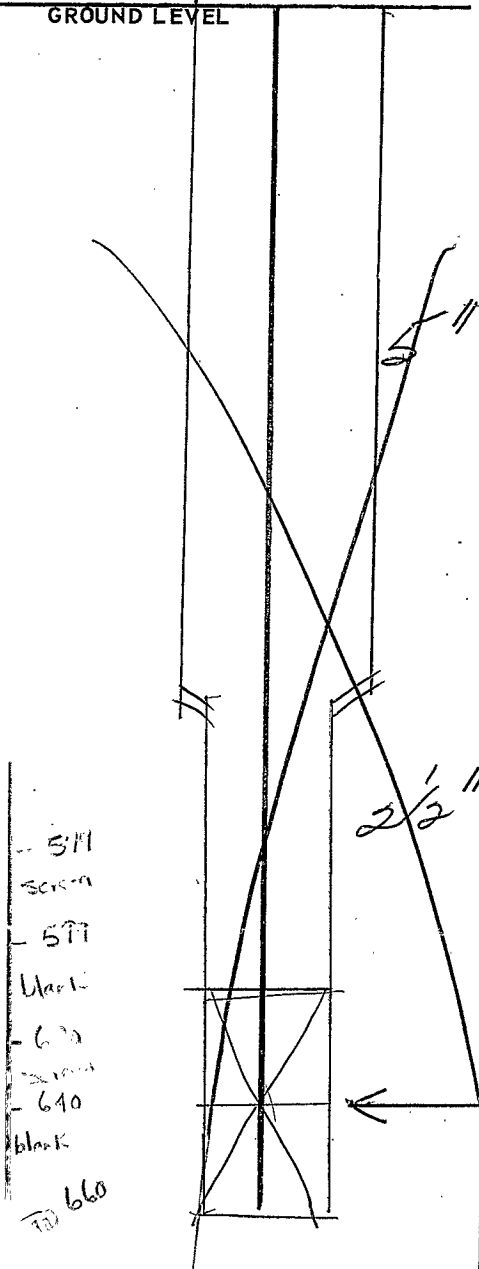

|  |  |  |   |
|--|--|--|---|
|  |  |  |   |
|  |  |  |   |
|  |  |  | X |
|  |  |  |   |

SECTION 23

Please indicate well location X.

ADDITIONAL INFORMATION

If more than one screen,  
show locations of each on sketch.