

Lown des
 Ø 3A
 11-11-80

MISSISSIPPI
 BOARD OF WATER COMMISSIONERS
 416 North State Street
 Jackson, Mississippi 39201

CODED

WATER WELL DRILLERS LOG

11-11 date well completed 1980 Ahw sup Drilling Inc. firm name Lown des county well located

LANDOWNER: Weyerhaeuser
P.O. Box 1620
Columbus, Ms. 39701
 (mailing address)

WELL LOCATION:
 sec. 1 T. 25 N. R. 17 E.
8 miles S of Columbus
 (distance) (direction) (nearest town)

WELL PURPOSE: Canteen well
 (home, irrigation, municipal, industrial)

WELL COMPLETION DATA:

(1) diameter (inches) 6" x 3"

(2) total depth (feet) 643'

(3) static water level (feet) 47' below above
 top of ground.

(4) casing 6" PVC 240'
 (material) (depth)

6x3 if telescope see back.
 (size)

(5) screen 200' 443'
 (length) (depth to top)

6"x3" plastic
 (size) (material)

(6) pump 10 100
 (HP) (yield gpm)

Electric
 (type power)

(7) electric log NO
 (yes or no)

(organization running log)

(8) how well bottom plugged

description of formations encountered	from	to
Top soil	0	40
SHALE	40	120
WHITE Rock	120	308
HARD Rock	308	330
MUC. R. G.	330	360
SAND-DRIVE	360	416
MUC. R.	416	420
SAND-DRIVE	420	443
WATER SAND	443	643

CODED

DEPT. OF NATURAL RESOURCES
 BUREAU OF LAND & WATER RESOURCES

MAY 20 1981

RECEIVED

DRILLERS REMARKS:

7

If well telescopes please sketch and show depths.


GROUND LEVEL



240'
6"

210'3"
Casing

200'3"
screen

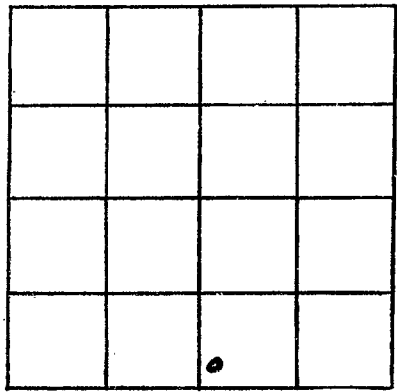

SECTION 1

Please indicate well location X.

ADDITIONAL INFORMATION

A series of horizontal lines for providing additional information.

If more than one screen, show locations of each on sketch.