

LOWNDES  
 Q 35

MISSISSIPPI  
 BOARD OF WATER COMMISSIONERS  
 416 North State Street  
 Jackson, Mississippi 39201

CODED

WATER WELL DRILLERS LOG

10/24 1979 Allsup Drilling, Inc. Lowndes  
 date well completed firm name county well located

LANDOWNER: Charity Mission Church  
 RR 1, Box 242  
 Crawford, MS 39743  
 (mailing address)

description of formations encountered	from	to
Clay	0	12'
LIME ROCK	12'	480'
1st SAND	480'	530'
Muck	530'	580'
SAND	580'	600'

WELL LOCATION:  
 sec. 30 T. 17 N R. 17 E  
 3 1/2 miles E of Crawford  
 (distance) (direction) (nearest town)

CODED

WELL PURPOSE: Church  
 (home, irrigation, municipal, industrial)

- WELL COMPLETION DATA:
- (1) diameter (inches) 4"
  - (2) total depth (feet) 600'
  - (3) static water level (feet) 70' below top of ground.
  - (4) casing PVC (material), (depth), 4" x 2" (size) if telescope see back.
  - (5) screen 80' (length), 520' (depth to top), 2" (size), PVC (material)
  - (6) pump 1/2 (HP), 15 (yield gpm), Electric (type power)
  - (7) electric log no (yes or no)
  - (organization running log)
  - (8) how well bottom plugged capped

DRILLERS REMARKS:

DEPT. OF NATURAL RESOURCES  
 BUREAU OF LAND & WATER RESOURCES

JUN 21 1984

RECEIVED

If well telescopes please sketch and show depths.


GROUND LEVEL

26' 4" CASING

468' LIME ROCK

200' 2" CASING

80' 2" SCREEN

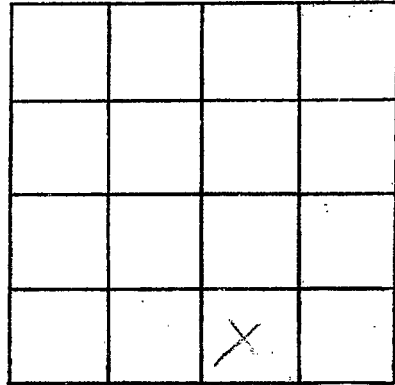

SECTION 30

Please indicate well location X.

ADDITIONAL INFORMATION

0052

If more than one screen, show locations of each on sketch.