

26

LOWMEDES
 037
 8/85

MISSISSIPPI
 BOARD OF WATER COMMISSIONERS
 416 North State Street
 Jackson, Mississippi 39201

CODED

WATER WELL DRILLERS LOG

Alhsup Drilling Inc. Lowmedes
 firm name county well located

19
 date well completed

LANDOWNER: Weyerhaeuser
P.O. Box 1620
Columbus, Ms. 39701
 (mailing address)

| description of formations encountered | from | to |
|---------------------------------------|------|------|
| Top Soil | 0 | 40' |
| SHALE | 40' | 120' |
| White Rock | 120' | 308' |
| HARD ROCK | 308 | 330' |
| MUCK | 330' | 360' |
| SAND-GRAVEL | 360' | 416' |
| MUCK | 416' | 420' |
| SAND-GRAVEL | 420' | 443' |
| Water SAND | 443' | 740' |

WELL LOCATION:
 sec. 11 T 20 N R 17 E
 S W
8 miles S of Columbus
 (distance) (direction) (nearest town)

WELL PURPOSE: PAPER MILL
 (home, irrigation, municipal, industrial)

- WELL COMPLETION DATA:
- diameter (inches) 6"
 - total depth (feet) 740'
 - static water level (feet) 50' below above top of ground.
 - casing PVC, 740'
 (material) (depth)
6"x3" if telescope see back.
 (size)
4" - 100' - 440'
 (5) screen 3" - 200' - 540'
 (length) (depth to top)
4"x3", PVC
 (size) (material)
 - pump 10 100
 (HP) (yield gpm)
Electric
 (type power)
 - electric log
 (yes or no)
 - (organization running log)
 - how well bottom plugged CAP

CODED

RECEIVED
 AUG 27 1985

DRILLERS REMARKS:

Department of Natural Resources
 Bureau of Land Management

If well telescopes please sketch and show depths.


GROUND LEVEL

240' 16" CASING

200' 4" CASING

100' 4" Commercial
SCREEN

200' 3" Commercial
SCREEN

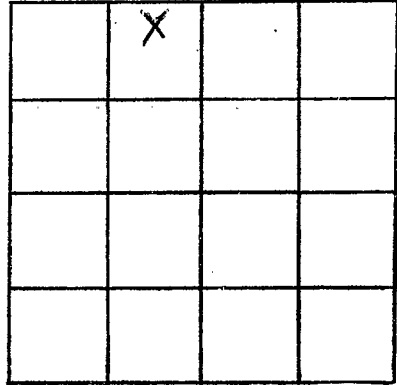

SECTION 11

Please indicate well location X.

ADDITIONAL INFORMATION

If more than one screen,
show locations of each on sketch.