

LOWNDES
 Q 39
 8/85

MISSISSIPPI
 BOARD OF WATER COMMISSIONERS
 416 North State Street
 Jackson, Mississippi 39201

CODED

WATER WELL DRILLERS LOG

Abbsup Drilling Inc. Lowndes -
 firm name county well located

date well completed 19

LANDOWNER: Weyerhaeuser
P.O. Box 1620
Columbus, MS. 39701
 (mailing address)

description of formations encountered	from	to
Top Soil	0	40'
Shale	40'	120'
White Rock	120'	308'
HARD ROCK	308'	330'
MUCK	330'	360'
SAND - Gravel	360'	416'
MUCK	416'	420'
SAND - GRAVEL	420'	443'
Water SAND	443'	740'

WELL LOCATION:
 sec. 11 T. 20 N. R. 17 E.
 S. #
8 miles S of Columbus
 (distance) (direction) (nearest town)

WELL PURPOSE: WOOD YARD
 (home, irrigation, municipal, industrial)

WELL COMPLETION DATA:

(1) diameter (inches) 6"

(2) total depth (feet) 740'

(3) static water level (feet) 50' below above top of ground.

(4) casing PVC, 740'
 (material) (depth)

6" x 3" If telescope see back.
 (size) 4" - 100' - 440'

(5) screen 3" - 200' - 540'
 (length) (depth to top)

4" x 3", PVC
 (size) (material)

(6) pump 10 100
 (HP) (yield gpm)

Electric
 (type power)

(7) electric log NO
 (yes or no)

(organization running log)

(8) how well bottom plugged CAP

CODED

RECEIVED
 AUG 27 1985

DRILLERS REMARKS:

Department of Natural Resources
 Bureau of Land & Water Management

If well telescopes please sketch and show depths.


GROUND LEVEL

240' 6" casing

200' 4" casing

100' 4" Commercial Screen

200' 3" Commercial Screen

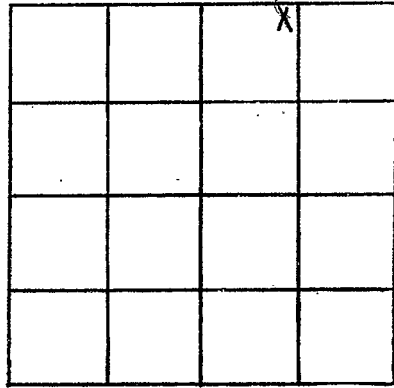

SECTION 11

Please indicate well location X.

ADDITIONAL INFORMATION

02

If more than one screen, show locations of each on sketch.