

LOWNDES
 02001
 8-11-76

MISSISSIPPI
 BOARD OF WATER COMMISSIONERS
 416 North State Street
 Jackson, Mississippi 39201

WATER WELL DRILLERS LOG

Aug. 11 1976 Akhsup Drilling INC. LOWNDES
 date well completed firm name county well located

LANDOWNER: Mr. Williams Robertson	description of formations encountered	from	to
Rt 1 Box 61	Top soil	0	10
Crawford, MS 39743 (mailing address)	Lime Rock	10	260
WELL LOCATION: sec 22 T 17 N R 17 E	1st SAND	260	300
6 1/2 miles W of Crawford (distance) (direction) (nearest town)	Muck	300	340
WELL PURPOSE: none (home, irrigation, municipal, industrial)	2nd SAND	340	450
WELL COMPLETION DATA:			
(1) diameter (inches) 4" x 2"			
(2) total depth (feet) 450'			
(3) static water level (feet) 70 below top of ground.			
(4) casing 4" plastic, 20' (material) (depth)			
4" x 2" If telescope see back. (size)			
(5) screen 80' 340' (length) (depth to top)			
2" plastic (size) (material)			
(6) pump 1/2 11 (HP) (yield gpm)			
Electric (type power)			
(7) electric log NO (yes or no)			
(organization running log)			
(8) how well bottom plugged CAP			
DRILLERS REMARKS:			

RECEIVED


MAY 1 1978

MISS. BD. OF WATER COMM

If well telescopes please sketch and show depths.

GROUND LEVEL

20' 11"
 casing

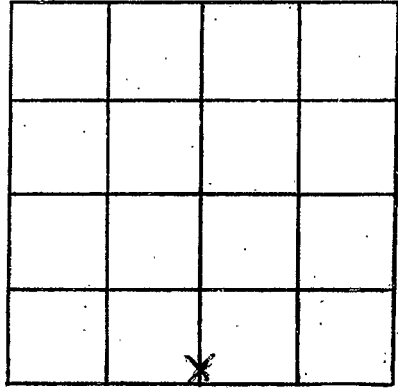

SECTION 22

Please indicate well location X.

ADDITIONAL INFORMATION

120' 2"
 casing

80' 0" casing

If more than one screen, show locations of each on sketch.