

LOWNDES

02002

6-2-77

MISSISSIPPI BOARD OF WATER COMMISSIONERS
416 North State Street
Jackson, Mississippi 39201

WATER WELL DRILLERS LOG

June 2 1977 ALH SUP Drilling INC Lowndes
date well completed firm name county well located

LANDOWNER	description of formations encountered	from	to
MR. THATTIS HAIRSTON Rt 1 Box 53 Crawford MS. 39743 (mailing address)	Top Soil	0	8
	Lime Rock	8	410
	1st SAND	410	450
	Muck	450	465
	2nd SAND	465	600

LANDOWNER: MR. THATTIS HAIRSTON
Rt 1 Box 53
Crawford MS. 39743
(mailing address)

WELL LOCATION:
sec 24 T 20 N R 17 E
15 17 NS S of Columbus
(distance) (direction) (nearest town)

WELL PURPOSE:
(home, irrigation, municipal, industrial)

WELL COMPLETION DATA:

- (1) diameter (inches) 4" x 2"
- (2) total depth (feet) 600'
- (3) static water level (feet) 70' ^{below} _{above} top of ground.
- (4) casing 4" plastic 20' (material) (depth)
2" If telescope see back. (size)
- (5) screen 80' 520' (length) (depth to top)
4" x 2" plastic (size) (material)
- (6) pump 1/2 10 (HP) (yield gpm)
Electric (type power)
- (7) electric log NO (yes or no)

(organization running log)

(8) how well bottom plugged CAP

DRILLERS REMARKS:

RECEIVED
MAY 12 1978
MISS. BD. OF WATER COMMISSIONERS


If well telescopes please sketch and show depths.

GROUND LEVEL

20'
4"
Casing

200'
2"
Casing

30'
2"
C. Screen

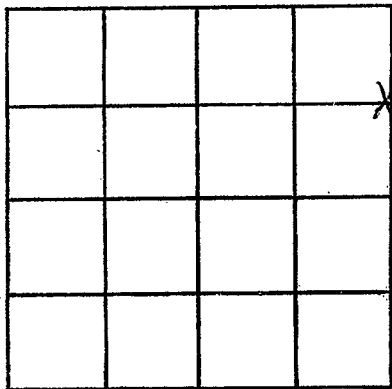

SECTION 24

Please indicate well location X.

ADDITIONAL INFORMATION

If more than one screen, show locations of each on sketch.