

LOWDES
 2004
 10-4-78

MISSISSIPPI
 BOARD OF WATER COMMISSIONERS
 416 North State Street
 Jackson, Mississippi 39201

WATER WELL DRILLERS LOG

Oct 4 1977 ALL Star Drilling, INC. Lowdes
 date well completed firm name county well located

LANDOWNER: Mrs. Minnie
 Lee Hairston
 R+ 1 Box 58
 Crawford MS. 39743
 (mailing address)

description of formations encountered	from	to
Top Soil	0	8
Lime Rock	8	410
1st SAND	410	450
Muc K	450	465
2nd SAND	465	600

WELL LOCATION:
 sec. 27 T 17 N R 17 E
 6 1/4 miles E of Crawford
 (distance) (direction) (nearest town)

WELL PURPOSE: home
 (home, irrigation, municipal, industrial)

- WELL COMPLETION DATA:
- (1) diameter (inches) 4" x 2"
 - (2) total depth (feet) 600'
 - (3) static water level (feet) 70' below top of ground.
 - (4) casing 4" plastic (material), 20' (depth), 2" (size) If telescope see back.
 - (5) screen 80' (length), 5-20' (depth to top), 2" (size), plastic (material)
 - (6) pump 1/2 (HP), 10 (yield gpm), Electric (type power)
 - (7) electric log NO (yes or no)
 - (8) how well bottom plugged CAP

DRILLERS REMARKS:

RECEIVED
 JUL 16 1978
 MISS. BD. OF WATER COMM.


If well telescopes please sketch and show depths.

GROUND LEVEL

30'
4"
Casing

200'
2" Casing

40'
2"
Conventional
cells

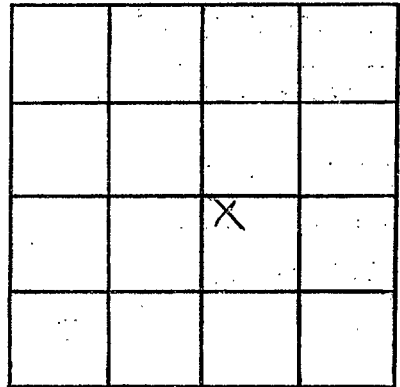

SECTION 27

Please indicate well location X.

ADDITIONAL INFORMATION

If more than one screen, show locations of each on sketch.