

LOWNDES  
0 1067

MISSISSIPPI  
BOARD OF WATER COMMISSIONERS  
416 North State Street  
Jackson, Mississippi 39201

WATER WELL DRILLERS LOG

July 8 1977 date well completed  
Allsup Drilling Inc firm name  
Lowndes county well located

LANDOWNER: Mr. Legare  
Hristow Rt 1 Box 46  
Crawford Ms. 39743  
(mailing address)

description of formations encountered	from	to
Top Soil	0	8
lime Rock	8	410
1st SAND	410	450
Muck	450	465
2nd SAND	465	600

WELL LOCATION:  
sec 28 T. 17 N R. 17 W  
4 3/4 miles EAST of Crawford  
(distance) (direction) (nearest town)

WELL PURPOSE: home  
(home, irrigation, municipal, industrial)

WELL COMPLETION DATA:

- (1) diameter (inches) 4" x 2"
- (2) total depth (feet) 600'
- (3) static water level (feet) 76 below top of ground
- (4) casing Plastic, 2" (material) (depth) 4' x 2" if telescope see back (size)
- (5) screen 8' x 52" (length) (depth to top)
- 4' x 2" Plastic (size) (material)
- (6) pump 1/2 (HP) 9 (yield gpm)
- ELECTRIC (type power)
- (7) electric log NO (yes or no)

(organization running log)

(8) how well bottom plugged cap


DRILLERS REMARKS:

RECEIVED  
JUN 14 1978  
MISS. BD. OF WATER COM.

If well telescopes please sketch and show depths.

GROUND LEVEL

20'  
4" casing

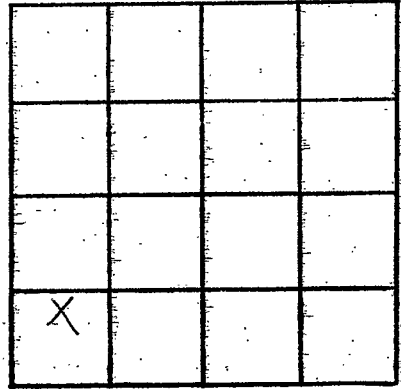

SECTION 28

Please indicate well location X.

ADDITIONAL INFORMATION

200'  
2" casing

80'  
2" screen

If more than one screen, show locations of each on sketch.