

LOWNDES
 0 2008
 11-1-77

MISSISSIPPI
 BOARD OF WATER COMMISSIONERS
 416 North State Street
 Jackson, Mississippi 39201

WATER WELL DRILLERS LOG

Nov 1 1977 Alhsup Drilling Inc. Lowndes
 date well completed firm name county well located

LANDOWNER: Mr. Lott Fields
 + wife - Ledora
 Route 1 Box 56
 Crawford, MS. 39743
 (mailing address)

description of formations encountered	from	to
Top Soil	0	10
Lime Rock	10	260
1st SAND	260	300
Muck	300	340
2nd SAND	340	500

WELL LOCATION:
 sec. 36 T 17 N R 17 E
 8 miles E of Crawford
 (distance) (direction) (nearest town)

WELL PURPOSE: home
 (home, irrigation, municipal, industrial)

WELL COMPLETION DATA:

(1) diameter (inches) 4" x 2"

(2) total depth (feet) 500'

(3) static water level (feet) 78' below top of ground.

(4) casing 4" plastic, 20' (material) (depth)
 2" (size) if telescope see back.

(5) screen 80' 420' (length) (depth to top)
 2" plastic (size) (material)

(6) pump 1/2 (HP) 9 (yield gpm)
 Electric (type power)

(7) electric log NO (yes or no)

(organization running log)

(8) how well bottom plugged cap


RECEIVED
 JUN 15 1978

MISS. BD. OF WATER COMM.

DRILLERS REMARKS:

If well telescopes please sketch and show depths.


GROUND LEVEL

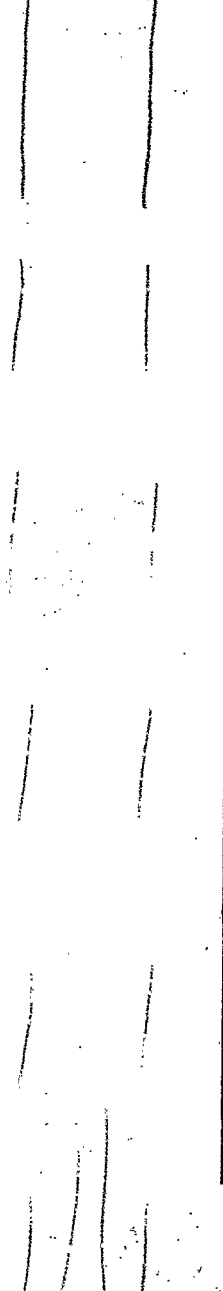

20'
4"
Casing

500'
2"
Casing

80'
Screen

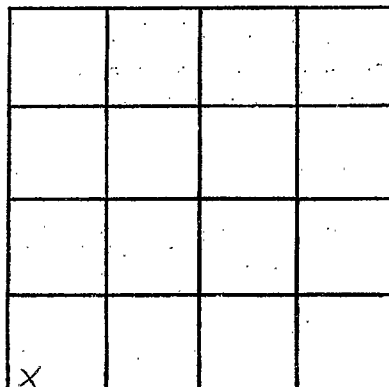

SECTION 36

Please indicate well location X.

ADDITIONAL INFORMATION

If more than one screen, show locations of each on sketch.