

LOWDE'S

0 2089

4-5-78

MISSISSIPPI
BOARD OF WATER COMMISSIONERS
416 North State Street
Jackson, Mississippi 39201

WATER WELL DRILLERS LOG

APR 25 1978
date well completed

ALLSUD DRILLING INC.
firm name

LOWNDES
county well located

LANDOWNER: Miss Laura
McGee Rt 1 Box 280
Columbus MS. 39701
(mailing address)

description of formations
encountered

from to

CLAY	0	2
Lime Rock	2	380
1st SAND	380	440
Muck	440	470
2nd SAND	470	556

WELL LOCATION:

sec. 17 T 17 N R 17 E
4 miles E of Crawford
(distance) (direction) (nearest town)

WELL PURPOSE: home
(home, irrigation, municipal, industrial)

WELL COMPLETION DATA:

- (1) diameter (inches) 4" x 2"
- (2) total depth (feet) 556'
- (3) static water level (feet) 80' below top of ground
- (4) casing 4" x 2" plastic, 26' (material) (depth)
- 4" x 2" if telescope see back. (size)
- (5) screen 80' 476' (length) (depth to top)
- 4 x 10" plastic (size) (material)
- (6) pump 1/2 HP 10 (yield gpm)
- Electric (type power)
- (7) electric log NO (yes or no)

(organization running log)

(8) how well bottom plugged CAP

DRILLERS REMARKS:


RECEIVED

JUN - 6 1978

MISS. BD. OF WATER COMMISSIONERS

If well telescopes please sketch and show depths.

GROUND LEVEL

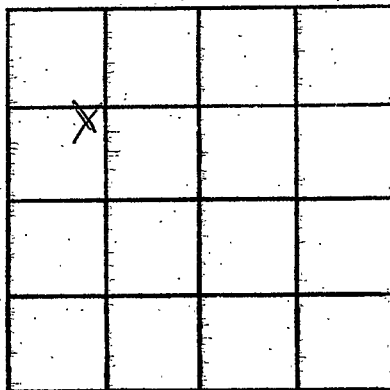

SECTION

13

Please indicate well location X.

ADDITIONAL INFORMATION

If more than one screen, show locations of each on sketch.