

LOWndos  
 O 2010  
 5/28/79

MISSISSIPPI  
 BOARD OF WATER COMMISSIONERS  
 416 North State Street  
 Jackson, Mississippi 39201

WATER WELL DRILLERS LOG

5-28 1979  
 date well completed

Rafter 55  
 firm name

Lawyer  
 county well located

LANDOWNER: Seth Markin  
 Columbus, Miss

description of formations encountered

from to

Top Soil 0 17  
 Blue Rock 17 130  
 Sand 130 252

(mailing address)

WELL LOCATION:

sec. 17 T~~19~~ N R. 17 E  
 8 17 S W  
 (distance) miles NE of Brantley  
 (direction) (nearest town)

WELL PURPOSE:

(home, irrigation, municipal, industrial)

WELL COMPLETION DATA:

- (1) diameter (inches) 4 X 2
- (2) total depth (feet) 252
- (3) static water level (feet) 47 below top of ground.
- (4) casing Plastic, 20' (material) (depth)  
 4" X 2" (size) If telescope see back.
- (5) screen 100' 152' (length) (depth to top)  
 2" Plastic (size) (material)
- (6) pump 1 8 (HP) (yield gpm)  
 Elect (type power)
- (7) electric log (yes or no)
- (organization running log)
- (8) how well bottom plugged

Miss. Board of Water Comm.  
 State Board of Water Comm.

JUL 5 1979  
 JUL 5 1979


RECEIVED

DRILLERS REMARKS:

If well telescopes please sketch and show depths.

GROUND LEVEL

20'  
4" casing  
92'  
Blue  
Rock  
40'  
2" casing  
100'  
2" screen  
screen

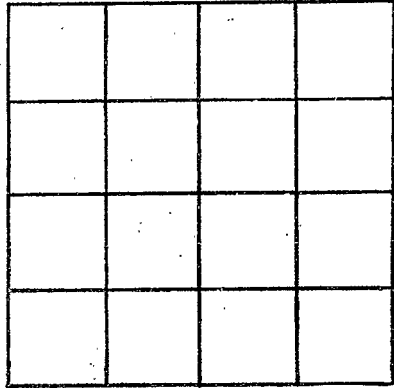

SECTION \_\_\_\_\_

Please indicate well location X.

ADDITIONAL INFORMATION

I do not have  
Lawrence County Map

If more than one screen,  
show locations of each on sketch.