

Lowndes
 2012

MISSISSIPPI
 BOARD OF WATER COMMISSIONERS
 416 North State Street
 Jackson, Mississippi 39201

WATER WELL DRILLERS LOG

6/1 19 80 Allsup Drilling, Inc. Lowndes
 date well completed firm name county well located

LANDOWNER: <u>Mattie Inez</u> <u>RR 1, Box 60</u>	description of formations encountered	from	to
<u>Crawford, MS 39743</u> (mailing address)	<u>HAIRSTON</u> <u>TOP SOIL</u>	<u>0</u>	<u>12</u>
WELL LOCATION: sec <u>22</u> T <u>17</u> N R <u>17</u> E <u>6 1/2</u> miles <u>E</u> of <u>Crawford</u> (distance) (direction) (nearest town)	<u>CLAY</u> <u>ROCK</u>	<u>12</u> <u>25</u>	<u>25</u> <u>285</u>
WELL PURPOSE: <u>Home</u> (home, irrigation, municipal, industrial)	<u>SAND & GRAVEL</u> <u>WATER SAND</u>	<u>285</u> <u>520</u>	<u>520</u> <u>600</u>
WELL COMPLETION DATA: (1) diameter (inches) <u>4" x 2"</u> (2) total depth (feet) <u>600'</u> (3) static water level (feet) <u>65</u> below above top of ground. (4) casing <u>Plastic</u> (material), (depth) <u>4" x 2"</u> (size) if telescope see back. (5) screen <u>80'</u> (length), <u>520</u> (depth to top) <u>2"</u> (size), <u>Plastic</u> (material) (6) pump <u>1/2</u> (HP), <u>10</u> (yield gpm) <u>Electric</u> (type power) (7) electric log <u>No.</u> (yes or no) (organization running log) (8) how well bottom plugged <u>Capped</u>			
DRILLERS REMARKS:			

6/21/80
[Signature]

If well telescopes please sketch and show depths.

GROUND LEVEL


600' Well

27' 4" Casing

Rock

240' 2" casing

80' Screen

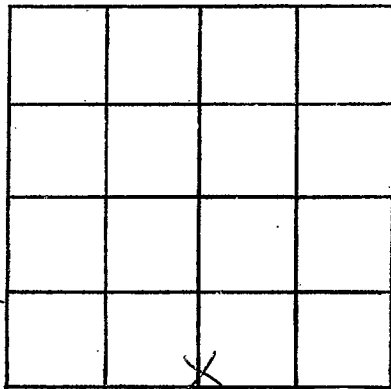

SECTION 22

Please indicate well location X.

ADDITIONAL INFORMATION

If more than one screen, show locations of each on sketch.