

MISSISSIPPI DEPARTMENT OF NATURAL RESOURCES

Bureau of Land and Water Resources

Southport Mall

P.O. Box 10631

Jackson, Mississippi 39209

WATER WELL DRILLERS LOG

Lowndes
12/81

12/8 date well completed 1981 Allsup Drilling, Inc. firm name Lowndes county well located

LANDOWNER: <u>Ida May Harris</u>	description of formations encountered	from	to
<u>RR 1, Box 52</u>			
<u>Crawford, MS 39743</u> (mailing address)	<u>Lime Rock</u>	<u>8'</u>	<u>410'</u>
WELL LOCATION:	<u>1st Sand</u>	<u>410'</u>	<u>450'</u>
sec. <u>34</u> T. <u>17</u> N. R. <u>17</u> E #	<u>Muck</u>	<u>450'</u>	<u>465'</u>
<u>6 1/2</u> miles <u>EAST</u> of <u>Crawford</u> (distance) (direction) (nearest town)	<u>2nd Sand</u>	<u>465'</u>	<u>600'</u>
WELL PURPOSE: <u>Home</u> (home, irrigation, municipal, industrial)			
WELL COMPLETION DATA:			
(1) diameter (inches) <u>4"</u>			
(2) total depth (feet) <u>600'</u>			
(3) static water level (feet) <u>70'</u> <u>below</u> above top of ground.			
(4) casing <u>PVC</u> (material) (depth) <u>4" x 2"</u> if telescope see back. (size)			
(5) screen <u>80'</u> (length) <u>520'</u> (depth to top)			
<u>2"</u> (size) <u>PVC</u> (material)			
(6) pump <u>1/4</u> (HP) <u>10</u> (yield gpm)			
<u>Electric</u> (type power)			
(7) electric log <u>No</u> (yes or no)			
(organization running log)			
(8) how well bottom plugged <u>Capped</u>			
DRILLERS REMARKS:			

DEPT. OF NATURAL RESOURCES
 BUREAU OF LAND & WATER RESOURCES

JUN 21 1984

RECEIVED

If well telescopes please sketch and show depths.


GROUND LEVEL

20' 4" CASING

402' LIME ROCK

200' 2" CASING

80' 2" SCREEN

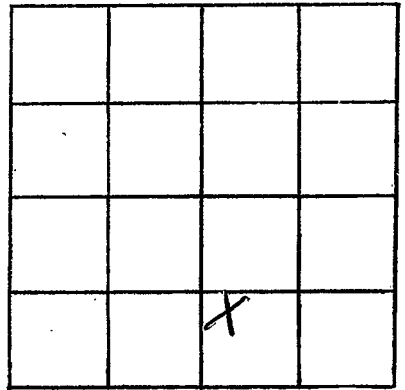

SECTION 34

Please indicate well location X.

ADDITIONAL INFORMATION

If more than one screen,
show locations of each on sketch.