

MISSISSIPPI DEPARTMENT OF NATURAL RESOURCES

Bureau of Land and Water Resources

Southport Mall

P.O. Box 10631

Jackson, Mississippi 39209

WATER WELL DRILLERS LOG

Landred  
0 2015

7-30-84, 19 Clardy Well Drilling Landred  
date well completed firm name county well located

LANDOWNER: Roy Stewart  
Columbus, Miss.  
(mailing address)

WELL LOCATION:  
sec. 22 T 20 N R. 17 E  
11 miles SW of Col.  
(distance) (direction) (nearest town)

WELL PURPOSE: home  
(home, irrigation, municipal, industrial)

- WELL COMPLETION DATA:
- (1) diameter (inches) 4"
  - (2) total depth (feet) 496'
  - (3) static water level (feet) 119 1/2 below top of ground.
  - (4) casing PVC, 193'  
(material) (depth)  
(size) if telescope see back.
  - (5) screen 40', 456'  
(length) (depth to top)  
2", PVC  
(size) (material)
  - (6) pump 3/4, 900 gpm  
(HP) (yield gpm)  
elec.  
(type power)
  - (7) electric log no.  
(yes or no)  
(organization running log)
  - (8) how well bottom plugged \_\_\_\_\_

description of formations encountered	from	to
brown clay	0	19
blue clay	19	48
lime rock	48	55
hard clay	55	148
gummy clay	148	178
good clay	178	197
rock 2"		
good clay	197	215
gummy clay	215	272
hard clay	272	288 1/2
rock	288 1/2	289
sand	289	311
sandy clay	311	412
hard clay	412	438 1/2
rock 6"		
sandy clay	439	441
rock 2"		
sand	441	451
rocky	451	453
sand	453	468
rock 6"	468	468 1/2
sand	468 1/2	496


DEPT. OF NATURAL RESOURCES  
BUREAU OF LAND & WATER RESOURCES

SEP - 4 1984  
RECEIVED


DRILLERS REMARKS: \_\_\_\_\_

If well telescopes please sketch and show depths.

GROUND LEVEL

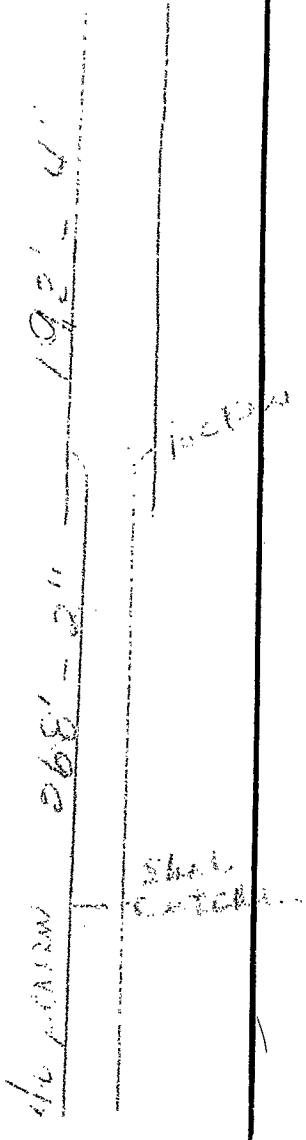

If more than one screen, show locations of each on sketch.

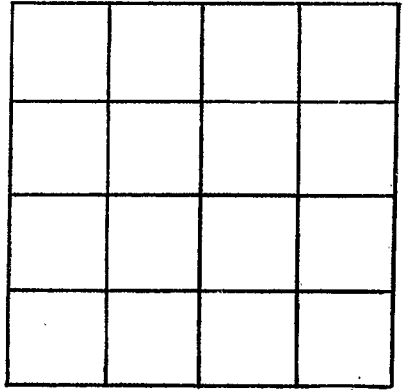

SECTION \_\_\_\_\_

Please indicate well location X.

ADDITIONAL INFORMATION

A series of horizontal lines for recording additional information.