

**MISSISSIPPI  
BOARD OF WATER COMMISSIONERS  
416 North State Street  
Jackson, Mississippi 39201**

**WATER WELL DRILLERS LOG**

*Lowndes*  
*02016*

10-29-84      19 Mid South Drilling Company      Lowndes  
date well completed      firm name      county well located

**LANDOWNER:** J. H. Aldridge

211 Constance Land

Columbus, MS 39701  
(mailing address)

**WELL LOCATION:**

sec. 17 T 20X R 17 EX  
*17N*      *17E*  
12 miles south of Columbus  
(distance)      (direction)      (nearest town)

**WELL PURPOSE:** home  
(home, irrigation, municipal, industrial)

**WELL COMPLETION DATA:**

- (1) diameter (inches) 4"
- (2) total depth (feet) 255
- (3) static water level (feet) 9 *below*  
top of ground. *observed*
- (4) casing PVC, 115'  
(material) (depth)  
4" If telescope see back.  
(size)
- (5) screen none  
(length) (depth to top)  
(size) (material)
- (6) pump 1/2 5  
(HP) (yield gpm)  
electric  
(type power)
- (7) electric log no  
(yes or no)  
no  
(organization running log)
- (8) how well bottom plugged open

description of formations encountered

from

to

clay	0	12
sand and gravel	12	28
clay	28	90
clay and sand	90	255
rock at 120'; 123'; 127'; 150'; 160'; 172'; and 184'		

**DRILLERS REMARKS:**


DEPT. OF NATURAL RESOURCES  
BUREAU OF LAND & WATER RESOURCES

NOV 26 1984

RECEIVED

If well telescopes please sketch and show depths.

GROUND LEVEL

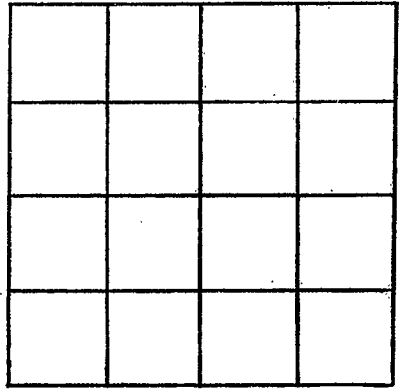

SECTION \_\_\_\_\_

Please indicate well location X.

ADDITIONAL INFORMATION

If more than one screen,  
show locations of each on sketch.