

Lowndes
Φ 2017
12-28-78

MISSISSIPPI
 BOARD OF WATER COMMISSIONERS
 416 North State Street
 Jackson, Mississippi 39201

WATER WELL DRILLERS LOG

12-28 1978 Anthony Drilly Co. Lowndes
 date well completed firm name county well located

LANDOWNER:	description of formations encountered	from	to
<u>Andrew Yoder</u> <u>Brooksville, Miss</u> (mailing address)			

WELL LOCATION:
 sec. 2 T. 17 N. R. 17 E.
15 miles S of Col
 (distance) (direction) (nearest town)

WELL PURPOSE: Home
 (home, irrigation, municipal, industrial)

- WELL COMPLETION DATA:
- (1) diameter (inches) 4 1/2"
 - (2) total depth (feet) 600'
 - (3) static water level (feet) 55 below above top of ground.
 - (4) casing PVC (material), (depth) _____
 _____ (size) If telescope see back.
 - (5) screen 30' (length), 570 (depth to top)
2" (size), PVC (material)
 - (6) pump 2 (HP), 30 (yield gpm)
elct (type power)
 - (7) electric log no (yes or no)
 _____ (organization running log)
 - (8) how well bottom plugged cased

DRILLERS REMARKS: _____

Miss. Board of Water Comm.

JUL 5 1979

RECEIVED

If well telescopes please
sketch and show depths.


GROUND LEVEL

40'
4 1/2"
PVC

500'
2"
PVC
Casey

30'
1008
Sloat
Johnson
Seizer
PVC

If more than one screen,
show locations of each on sketch.

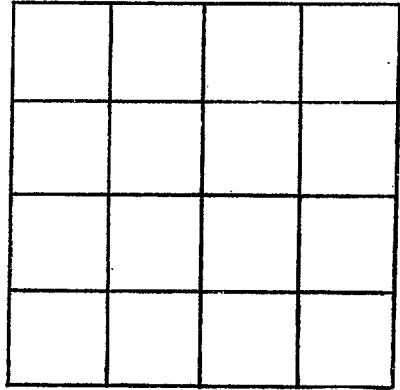

SECTION _____

Please indicate well location X.

ADDITIONAL INFORMATION

Horizontal lines for additional information.