

LOWNDES

Q 2018
6/18/79
6/18

MISSISSIPPI
BOARD OF WATER COMMISSIONERS
416 North State Street
Jackson, Mississippi 39201

WATER WELL DRILLERS LOG

date well completed 1979 firm name ALLSUP Drilling, Inc. county well located Lowndes

LANDOWNER: Mrs. Laura Hairston

description of formations encountered	from	to
Top Soil	0	12
lino. rock	12	500
1st sand	500	560
lmuch.	540	600
2nd sand	600	650

Rt. 1 Box 25
Crawford, MS. 39443
(mailing address)

WELL LOCATION:

sec 30 T 17 N R 17 E
4 miles E of Crawford
(distance) (direction) (nearest town)

WELL PURPOSE: name
(home, irrigation, municipal, industrial)

WELL COMPLETION DATA:

- (1) diameter (inches) 4" x 3"
- (2) total depth (feet) 650' 650'
- (3) static water level (feet) 90' below top of ground
- (4) casing 4" plastic 27' (material) (depth)
- 4" x 2" if telescope see back. (size)
- (5) screen 2" 80' 570' (length) (depth to top)
- 4" x 2" plastic (size) (material)
- (6) pump 1/2 9 (HP) (yield gpm)
- Electric (type power)
- (7) electric log NO (yes or no)

(organization running log)

(8) how well bottom plugged CAP

DRILLERS REMARKS:

DEPT. OF NATURAL RESOURCES
BUREAU OF LAND & WATER RESOURCES


AUG 8 1980

RECEIVED

If well telescopes please sketch and show depths.

GROUND LEVEL

27' 4"
Casing

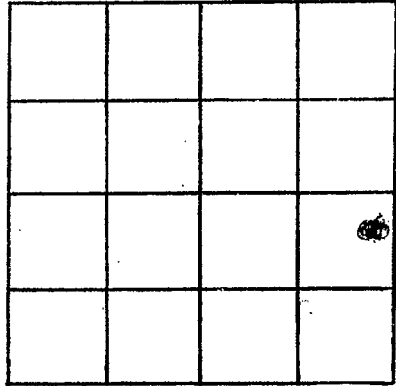

SECTION 30

Please indicate well location X.

ADDITIONAL INFORMATION

200' 2"
Casing

30' 2"
Commercial
Screen

If more than one screen,
show locations of each on sketch.