

Lowndes

MISSISSIPPI  
BOARD OF WATER COMMISSIONERS  
416 North State Street  
Jackson, Mississippi 39201

2020

7/2/80

WATER WELL DRILLERS LOG

July 2 80 Mid South Drilling Lowndes  
date well completed firm name county well located

LANDOWNER: <u>Dwight Pester</u>	description of formations encountered	from	to
<u>Columbus, MS 39701</u> (mailing address)	<u>clay</u>	<u>0</u>	<u>255</u>
WELL LOCATION: sec. <u>6</u> T. <u>17</u> N. R. <u>17</u> E <u>10</u> miles <u>SW</u> of <u>Col.</u> (distance) (direction) (nearest town)	<u>clay &amp; sand</u>	<u>255</u>	<u>350</u>
WELL PURPOSE: <u>Home</u> (home, irrigation, municipal, industrial)	<u>sand</u>	<u>350</u>	<u>360</u>
WELL COMPLETION DATA: (1) diameter (inches) <u>4</u> (2) total depth (feet) <u>630</u> (3) static water level (feet) <u>150</u> <u>below</u> top of ground. (4) casing <u>PVC</u> , <u>180</u> (material) (depth) <u>4</u> (size) if telescope see back. (5) screen <u>no</u> (length) (depth to top) (size) (material) (6) pump <u>no</u> (HP) (yield gpm) <u>no</u> (type power) (7) electric log <u>no</u> (yes or no) <u>no</u> (organization running log) (8) how well bottom plugged <u>open</u>	<u>sand</u>	<u>360</u>	<u>375</u>
	<u>clay &amp; sand</u>	<u>375</u>	<u>620</u>
	<u>clay</u>	<u>620</u>	<u>630</u>
DRILLERS REMARKS:			


DEPT. OF NATURAL RESOURCES  
BUREAU OF LAND & WATER RESOURCES

AUG 6 1980

RECEIVED

If well telescopes please sketch and show depths.

GROUND LEVEL

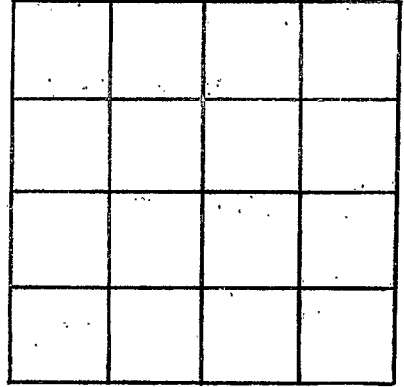

SECTION \_\_\_\_\_

Please indicate well location X.

ADDITIONAL INFORMATION

If more than one screen,  
show locations of each on sketch.