

Lowndes
Φ 2022
7-23-81

MISSISSIPPI
 BOARD OF WATER COMMISSIONERS
 416 North State Street
 Jackson, Mississippi 39201

WATER WELL DRILLERS LOG

7-23 1981 Alk Sup Drilling Inc. Lowndes
 date well completed firm name county well located

LANDOWNER: Mr. T.A. Caldwell
RR 6, Box 69
Columbus, Ms. 39701
 (mailing address)

description of formations encountered	from	to
Top Soil	0	12
lime Rock	12	450
1st SAND	450	500
Muck	500	580
2nd SAND	580	650

WELL LOCATION:
 sec. 33 T. 20 R. 17
6 miles E of Crawford
 (distance) (direction) (nearest town)

WELL PURPOSE: ~~BATCH BATCH~~
 (home, irrigation, municipal, industrial)
Home

- WELL COMPLETION DATA:
- (1) diameter (inches) 4" X 2"
 - (2) total depth (feet) 650'
 - (3) static water level (feet) 65 ^{below}/_{above} top of ground.
 - (4) casing 4" plastic, 30'
 (material) (depth)
4" X 2" if telescope see back.
 (size)
 - (5) screen 80', 570'
 (length) (depth to top)
4" X 2", plastic
 (size) (material)
 - (6) pump 1, 15
 (HP) (yield gpm)
Electric
 (type power)
 - (7) electric log NO
 (yes or no)
- (organization running log)
- (8) how well bottom plugged CAP

DRILLERS REMARKS:

DEPT. OF NATURAL RESOURCES
 BUREAU OF LAND & WATER RESOURCES


SEP 29 1981

RECEIVED

If well telescopes please sketch and show depths.

GROUND LEVEL

30' 4"
Casing

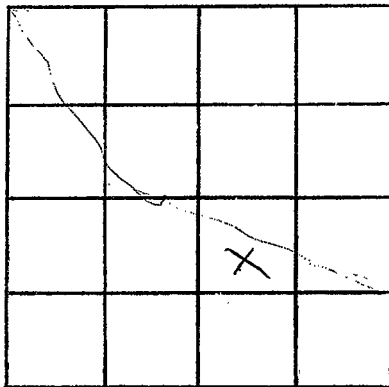

SECTION 33

Please indicate well location X.

ADDITIONAL INFORMATION

240' 2"
Casing

80' 2"

Commercial
Screen

If more than one screen,
show locations of each on sketch.