

MISSISSIPPI DEPARTMENT OF ENVIRONMENTAL QUALITY
Bureau of Land and Water Resources

P. O. Box 10631
Jackson, MS 39289-0631
WATER WELL DRILLERS LOG

COUNTY WELL LOCATED Lowndes	
WELL NUMBER 1292	CODED
2024	
DATE WELL COMPLETED 3-31-92	

PERMIT NUMBER 0-379
NAME OF DRILLING FIRM Mid South Drilling Co.
Carrollton, AL 35447

NAME & MAILING ADDRESS OF LANDOWNER Burt Chainoric c/o O. C. Electric P.O. Box 581			
Columbus, MS 39703			
WELL LOCATION:	SEC	TOWNSHIP	RANGE
	17	20 S	17 W
DISTANCE	DIRECTION	NEAREST TOWN	
12	S	Columbus	
OTHER LANDMARK			
WELL PURPOSE: Home, Irrigation, Municipal, Industrial, Fish Pond, etc.			

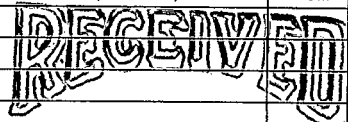
PUMP DATA		
PUMP TYPE (Circle One): Submersible, Turbine, Jet, Flowing Well, Other (Describe) _____		
POWER TYPE (Circle One): Electric, Tractor, Diesel, Gasoline, Butane, Other (Describe) _____ H/P _____		
Pump Capacity (GPM)	No. of Stages	Setting Depth FT.
PUMP TEST		
Well yielded _____ GPM with a drawdown of _____ ft. after _____ hours of pumping		

WELL DATA		
Well Depth 257	Casing Diameter (In.) 4	Casing Length (Ft.) 123
Type of Casing PVC	Hole Depth 257	Depth to Static Water Level 11
TYPE OF COMPLETION: (Circle One or More): Gravel Packed, Underreamed, Telescoped, Natural Development, Open Hole , Other (Describe) _____		
Top of Lap Pipe or Reduction in Casing FEET IF TELESCOPED OR MORE THAN ONE SCREEN: USE BACK PAGE		

LOG DATA	
TYPE OF LOG RUN (Circle One): Electric, Gamma Ray, Density, Sonic, Neutron, Other (Describe) _____ No Log Run	
Name of Organization Running Log	

SCREEN DATA		
Diameter - Inches	Length - Feet	Slot Size - Inches
Screen Type	Depth to Bottom - Feet	

GEOLOGIC DATA (Office Use Only)			
Surface Elev.	Geologic Unit	Unit Thickness	Depth to Top
Subs. SWL	Date	Analysis	Aquifer Test
Driller's Remarks			

DESCRIPTION OF FORMATIONS ENCOUNTERED	FROM	TO	FORMATIONS (Continued)	FROM	TO
clay	0	008	 APR 13 1992 Dept. of Environmental Quality Bureau of Land & Water Resources		
sand & gravel	008	032			
Clay	032	078			
clay w/sand streaks	078	095			
sand	095	121			
clay	121	160			
clay w/sand streaks	160	180			
sand w/clay streaks	180	200			
clay w/sand streaks	200	257			

IF MORE SPACE IS NEEDED, USE BACK

If well telescopes please
sketch and show depths.

GROUND LEVEL

SECTION _____

Please indicate well location X.

ADDITIONAL INFORMATION

If more than one screen,
show location of each on sketch.