

Lowndes
P10
6-20-72

MISSISSIPPI
 BOARD OF WATER COMMISSIONERS
 416 North State Street
 Jackson, Mississippi 39201

CODED

WATER WELL DRILLERS LOG

6-20 date well completed 1972 Anthony Drilling Co. firm name Lowndes county well located

LANDOWNER:	description of formations encountered	from	to
<u>Eugene Tate</u>	<u>Clay</u>	<u>0</u>	<u>4</u>
<u>Rt. Col. Miss</u> (mailing address)	<u>Limestone</u>	<u>6</u>	<u>160</u>
	<u>Sand & Shale</u>	<u>160</u>	<u>360</u>
WELL LOCATION:			
<u>sec 28 T 20 N R 18 E</u> <u>20</u> miles <u>South</u> of <u>Col.</u> (distance) (direction) (nearest town)			
WELL PURPOSE: <u>Home</u> (home, irrigation, municipal, industrial)			
WELL COMPLETION DATA:			
(1) diameter (inches) <u>4</u>			
(2) total depth (feet) <u>360</u>			
(3) static water level (feet) <u>50</u> <u>below</u> top of ground.			
(4) casing <u>P.V.C.</u> <u>20'</u> (material) (depth)			
<u>4x2</u> if telescope see back. (size)			
(5) screen <u>80'</u> <u>2"</u> (length) (depth to top) (size)			
<u>P.V.C.</u> (material)			
(6) pump <u>1</u> <u>5</u> (HP) (yield gpm)			
<u>elect.</u> (type power)			
(7) electric log <u>no</u> (yes or no)			
(organization running log)			
(8) how well bottom plugged <u>capped</u>			
DRILLERS REMARKS:			

CODED

SEP 19 1972


MISS. BD. OF
 WATER COM.

If well telescopes please sketch and show depths.

200' (faint)

GROUND LEVEL

4" P.V.C
Top Case

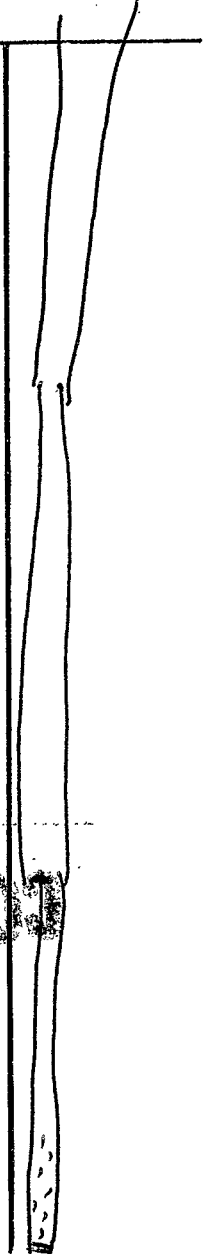

	X		

SECTION 2P

Please indicate well location X.

ADDITIONAL INFORMATION

200' (faint)
2" P.V.C.

80' 2"
P.V.C,
Prefabricated

If more than one screen,
show locations of each on sketch.