

LOWNDES  
P15

MISSISSIPPI  
BOARD OF WATER COMMISSIONERS  
416 North State Street  
Jackson, Mississippi 39201

**CODED**

12-22-72

**WATER WELL DRILLERS LOG**


Dec 22 1972 Clardywell & Pump Serv. Lowndes  
date well completed firm name county well located

LANDOWNER:	description of formations encountered	from	to
<u>Ike Savalle</u>			
<u>P.O. Box 82</u>	<u>sandy brown clay</u>	<u>0</u>	<u>5</u>
<u>Columbo, Miss</u>	<u>sand</u>	<u>5</u>	<u>15</u>
(mailing address)	<u>gravel</u>	<u>15</u>	<u>30</u>
	<u>blue clay</u>	<u>30</u>	<u>55</u>
<b>WELL LOCATION:</b>	<u>Fine sand + clay</u>	<u>55</u>	<u>75</u>
sec. <u>1</u> T. <u>20</u> N. R. <u>18</u> W.	<u>Fine sand</u>	<u>75</u>	<u>100</u>
S W	<u>blue clay</u>	<u>100</u>	<u>130</u>
<u>13</u> miles <u>S</u> of <u>Col.</u>	<u>sand</u>	<u>130</u>	<u>145</u>
(distance) (direction) (nearest town)	<u>blue clay</u>	<u>145</u>	<u>175</u>
<b>WELL PURPOSE:</b>	<u>Fine sand</u>	<u>175</u>	<u>185</u>
(home, irrigation, municipal, industrial)	<u>grey clay</u>	<u>180</u>	<u>210</u>
<b>WELL COMPLETION DATA:</b>	<u>sand + rocks</u>	<u>210</u>	<u>250</u>
(1) diameter (inches) <u>4</u>			
(2) total depth (feet) <u>250</u>			
(3) static water level (feet) <u>3</u> <small>below</small> <del>above</del> top of ground.			
(4) casing <u>steel</u> , <u>44</u> , (material) (depth)			
<u>        </u> If telescope see back. (size)			
(5) screen <u>        </u> , <u>        </u> (length) (depth to top)			
<u>        </u> , <u>        </u> (size) (material)			
(6) pump <u>        </u> <u>        </u> (HP) (yield gpm)			
<u>        </u> (type power)			
(7) electric log <u>        </u> (yes or no)			
<u>        </u> (organization running log)			
(8) how well bottom plugged <u>        </u>			
<b>DRILLERS REMARKS:</b> <u>Pump installed by customer</u>			

RECEIVED  
JAN 11 1973

If well telescopes please sketch and show depths.

GROUND LEVEL

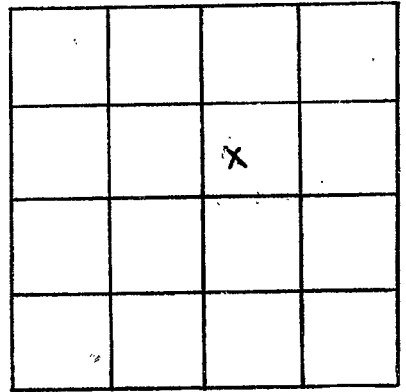

SECTION 1

Please indicate well location X.

ADDITIONAL INFORMATION

If more than one screen,  
show locations of each on sketch.