

LOWNDES

P 16

1-10-73

MISSISSIPPI
 BOARD OF WATER COMMISSIONERS
 416 North State Street
 Jackson, Mississippi 39201

CODED

WATER WELL DRILLERS LOG

1-10

1973 Anthony Drury Co.

Lowndes

date well completed

firm name

county well located

LANDOWNER:

Mary Jean Harris
 Rt 1 Columbus, Miss.
 (mailing address)

description of formations encountered

from

to

Clay	0	10
Limestone	10	250
Sand & shale	250	500

WELL LOCATION:

sec. 28 T 17 N R 18 E
 & W
15 miles S. of Col.
 (distance) (direction) (nearest town)

WELL PURPOSE: Home
 (home, irrigation, municipal, industrial)

WELL COMPLETION DATA:

- (1) diameter (inches) 4"
- (2) total depth (feet) 500'
- (3) static water level (feet) 70 below above top of ground.
- (4) casing 4" P.C. 21' Top
 (material) (depth)

_____ If telescope see back.
 (size)

- (5) screen 84' _____
 (length) (depth to top)
2" _____
 (size) (material)

- (6) pump 1/2 _____
 (HP) (yield gpm)
elect
 (type power)

- (7) electric log _____
 (yes or no)

_____ (organization running log)

- (8) how well bottom plugged Capped

DRILLERS REMARKS:

1557 7 10/73

If well telescopes please sketch and show depths.



GROUND LEVEL

4" PVC.

Open Hole

166'
2" PVC,
Solid

84' Screen
P.V.C.,

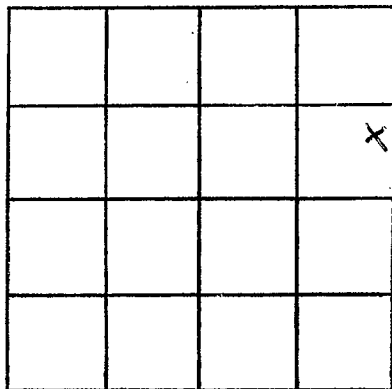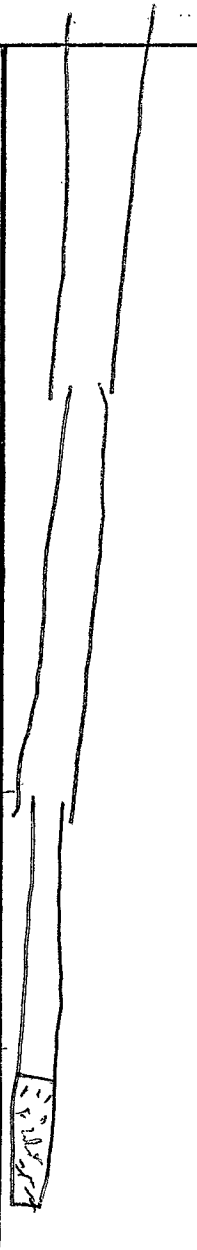

SECTION 28

Please indicate well location X.

ADDITIONAL INFORMATION

If more than one screen, show locations of each on sketch.