

LOWNDES
P 21
10/14/81

MISSISSIPPI
BOARD OF WATER COMMISSIONERS
416 North State Street
Jackson, Mississippi 39201
WATER WELL DRILLERS LOG

CODED

14 Oct. 1981 Herndon Well & Supply, Inc. Lowndes
date well completed firm name county well located

LANDOWNER: <u>Weyerhaeuser Co.</u>	description of formations encountered		from	to
Production Well #3	Brown Clay		0	15
Columbus, MS 39701 (mailing address)	Blue Clay		15	150
WELL LOCATION:	Clay & Sand Streaks		150	209
sec. <u>6</u> T. <u>17</u> N R. <u>18</u> E	Sandy Clay		209	250
10 miles South of Columbus (distance) (direction) (nearest town)	Clay		250	260
WELL PURPOSE: <u>Industrial</u> (home, irrigation, municipal, industrial)	Sandy Clay & Sand		260	310
WELL COMPLETION DATA:	Clay		310	330
(1) diameter (inches) <u>18"</u>	Sandy Clay		330	340
(2) total depth (feet) <u>1312.91</u>	Clay		340	365
(3) static water level (feet) <u>46.48</u> below top of ground.	Sand - Fine		365	380
(4) casing <u>Steel</u> , <u>1145</u> (material) (depth)	Clay		380	450
<u>18</u> if telescope see back. (size)	Sandy Clay & Sand Streaks		450	520
(5) screen <u>152.50</u> , <u>1150.36</u> (length) (depth to top)	Sand		520	580
<u>10"</u> , <u>Stainless Steel</u> (size) (material)	Clay		580	615
(6) pump <u>200</u> (HP) (yield gpm)	Sand		615	630
Electric (type power)	Clay		630	645
(7) electric log <u>yes</u> (yes or no)	Sand		645	660
<u>Schlumberger</u> (organization running log)	Clay		660	670
(8) how well bottom plugged <u>10 x 2"</u> <u>BW Valve</u>	Sand		670	685
	Clay		685	690
	Sand		690	700
	Clay		700	710
	Sand		710	785
	Pink Gumbo		785	870
	Sand		870	905
	Pink Gumbo		905	995
	Sand		995	1050
	Pink Gumbo		1050	1060
	Sand		1060	1070
	Pink Gumbo		1070	1080
	Sand		1080	1095
	Pink Gumbo		1095	1156
	Sand & Gravel		1156	1305
	Clay		1305	1339
DRILLERS REMARKS:				


FEB - 8 1982

RECEIVED

(X)

If well telescopes please sketch and show depths.

GROUND LEVEL

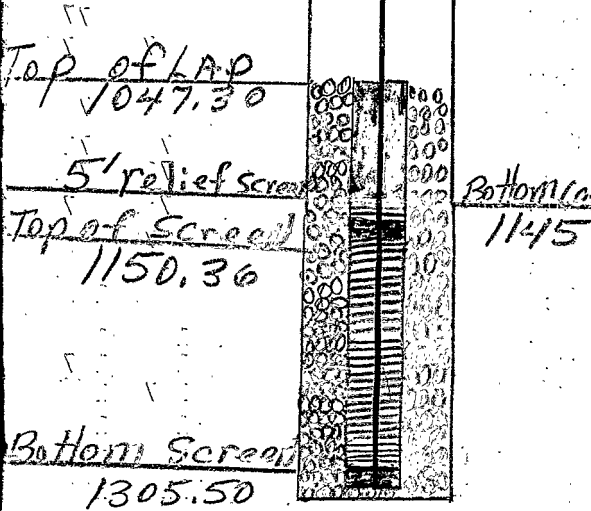

		X	

SECTION 10

Please indicate well location X.

ADDITIONAL INFORMATION

If more than one screen,
show locations of each on sketch.