

Lowndes  
 P22  
 5-16-80

MISSISSIPPI  
 BOARD OF WATER COMMISSIONERS  
 416 North State Street  
 Jackson, Mississippi 39201

CODED

WATER WELL DRILLERS LOG

5-16

1980 Abs Sup Drilling INC

Lowndes

date well completed

firm name

county well located

LANDOWNER: Weyerhaeuser

P.O. Box 1620

Columbus, Ms. 39201  
 (mailing address)

WELL LOCATION:

sec 7 T 20 N R 18 E  
8 miles S of Columbus  
 (distance) (direction) (nearest town)

WELL PURPOSE: trailers  
 (home, irrigation, municipal, industrial)

WELL COMPLETION DATA:

- (1) diameter (inches) 4" x 2"
- (2) total depth (feet) 604'
- (3) static water level (feet) 42' below top of ground
- (4) casing plastic - 176'  
 (material) (depth)  
4" x 2" if telescope see back.  
 (size)
- (5) screen 100' 504'  
 (length) (depth to top)  
4" x 2" plastic  
 (size) (material)
- (6) pump 2 HP 35  
 (HP) (yield gpm)  
Electric  
 (type power)
- (7) electric log NO  
 (yes or no)
- (organization running log)
- (8) how well bottom plugged

description of formations encountered

from

to

Top soil	0	30
Clay Rock	30	85
HARD ROCK	75	402
MUCK	402	412
SAND	412	488
MUCK	488	490
Sand	490	604

CODED

DEPT. OF NATURAL RESOURCES  
 BUREAU OF LAND & WATER RESOURCES

MAY 20 1981

RECEIVED


DRILLERS REMARKS:

well for trailers set up for temporary offices - to furnish water for workers, trucks equipment etc.

Well telescopes please  
Sketch and show depths.

GROUND LEVEL

176'  
4"

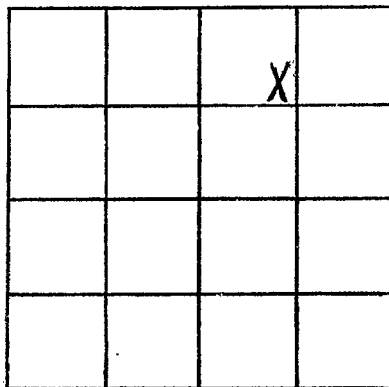

SECTION 7

Please indicate well location X.

ADDITIONAL INFORMATION

332' 2"

100' 2"  
screen

If more than one screen,  
show locations of each on sketch.