

Lowndes
 P 23
 9-19-80

MISSISSIPPI
 BOARD OF WATER COMMISSIONERS
 416 North State Street
 Jackson, Mississippi 39201

CODED

WATER WELL DRILLERS LOG

9-19

date well completed

1980 Ahl Sup Drilling Inc. Lowndes

firm name

county well located

LANDOWNER: Weyerhaeuser
P.O. Box 1620
Columbus MS. 39701
 (mailing address)

description of formations encountered

from to

WELL LOCATION:
 sec. 6 T. 19 N. R. 18 E
8 miles S of Columbus
 (distance) (direction) (nearest town)

Top Soil	0	20
CLAY	20	35
CHALK	35	450
White Rock	480	500
Water Sand	1100	720

WELL PURPOSE: BATCH PLANT
 (home, irrigation, municipal, industrial)

WELL COMPLETION DATA:

- (1) diameter (inches) 4" x 2"
- (2) total depth (feet) 720'
- (3) static water level (feet) 42' below top of ground.
- (4) casing 4" plastic 590'
 (material) (depth)
4" x 2" if telescope see back.
 (size)
- (5) screen 3" 120' 600'
 (length) (depth to top)
4" x 2" plastic
 (size) (material)
- (6) pump 3 HP 45
 (HP) (yield gpm)
Electric
 (type power)

(7) electric log (yes or no)

(organization running log)

(8) how well bottom plugged _____

DRILLERS REMARKS:

CODED

DEPT. OF NATURAL RESOURCES
 BUREAU OF LAND & WATER RESOURCES

MAY 20 1981

RECEIVED


If well telescopes please sketch and show depths.

GROUND LEVEL

590' 4"
Casing

20'
2"

120' 2"
Sandfree
Screens

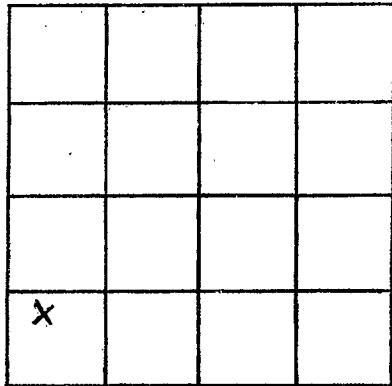

SECTION 6

Please indicate well location X.

ADDITIONAL INFORMATION

If more than one screen,
show locations of each on sketch.