

Lowndes  
 P 24  
 8-22-80

MISSISSIPPI  
 BOARD OF WATER COMMISSIONERS  
 416 North State Street  
 Jackson, Mississippi 39201

CODED

WATER WELL DRILLERS LOG

8-22 date well completed      1980 Alkshup Drilling, Inc. firm name      Lowndes county well located

LANDOWNER: Weyerhaeuser  
P.O. Box 1620  
Columbus Ms. 39701  
 (mailing address)

description of formations encountered	from	to
Top Soil	0	30
CLAY	30	70
LIMESTONE	70	430
WHITE ROCK	420	557
IRON ORE + SAND	557	578
SAND	578	687

WELL LOCATION:  
 sec. 6 T. 18 N. R. 18 E  
8 miles S of Columbus  
 (distance) (direction) (nearest town)

WELL PURPOSE: Office Building  
 (home, irrigation, municipal, industrial)

- WELL COMPLETION DATA:
- diameter (inches) 6" x 3"
  - total depth (feet) 687'
  - static water level (feet) 42 below top of ground.
  - casing 6" plastic, 160' (material) (depth)  
6" x 3" if telescope see back. (size)
  - screen 110', 577' (length) (depth to top)  
6" x 3", plastic (size) (material)
  - pump 3, 35 (HP) (yield gpm)  
Electric (type power)
  - electric log (yes or no) \_\_\_\_\_  
 (organization running log) \_\_\_\_\_
  - how well bottom plugged CAP

CODED

DEPT. OF NATURAL RESOURCES  
 BUREAU OF LAND & WATER RESOURCES

MAY 20 1980

RECEIVED

DRILLERS REMARKS:  
 \_\_\_\_\_  
 \_\_\_\_\_  
 \_\_\_\_\_




If well telescopes please sketch and show depths.

GROUND LEVEL



160' 6"  
Casing

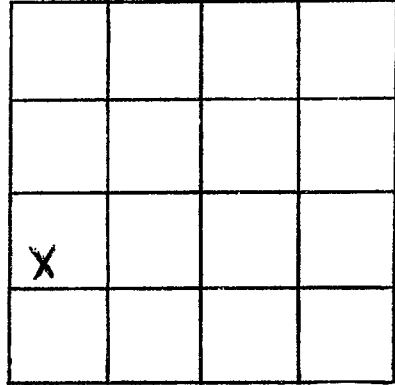

SECTION b

Please indicate well location X.

ADDITIONAL INFORMATION

Multiple horizontal lines for additional information.

442' 4"  
Casing

110' 3"  
Commercial  
Screens

If more than one screen, show locations of each on sketch.