

LOWNDES
 P 2000
 3-24-76

MISSISSIPPI
 BOARD OF WATER COMMISSIONERS
 416 North State Street
 Jackson, Mississippi 39201

WATER WELL DRILLERS LOG

March 24 1976 GALLSUP Drilling INC LOWNDES
 date well completed firm name county well located

LANDOWNER: Mr James Stewart
Rt 1 Box 37
Prairie Pt. Ms. 39353
 (mailing address)

description of formations encountered	from	to
Top Soil	0	10
Lime Rock	10	260
1st SAND	260	300
Muck	300	340
2nd SAND	340	600'

WELL LOCATION:
 sec. 28 T. 20 N. R. 18 E.
12 miles EAST of Crawford
 (distance) (direction) (nearest town)

WELL PURPOSE: home
 (home, irrigation, municipal, industrial)


WELL COMPLETION DATA:
 (1) diameter (inches) 4" X 2"
 (2) total depth (feet) 600'
 (3) static water level (feet) 20' ^{below} _{above} top of ground.
 (4) casing plastic, 40'
 (material) (depth)
4" X 2" if telescope see back.
 (size)
 (5) screen 30', 520'
 (length) (depth to top)
2", plastic
 (size) (material)
 (6) pump 1/2, 9
 (HP) (yield gpm)
Electric
 (type power)
 (7) electric log NO
 (yes or no)
 (organization running log)

(8) how well bottom plugged CAP
 DRILLERS REMARKS:

RECEIVED
 JUN 15 1978
 MISS. BD. OF WATER COMMISSIONERS

If well telescopes please sketch and show depths.

GROUND LEVEL

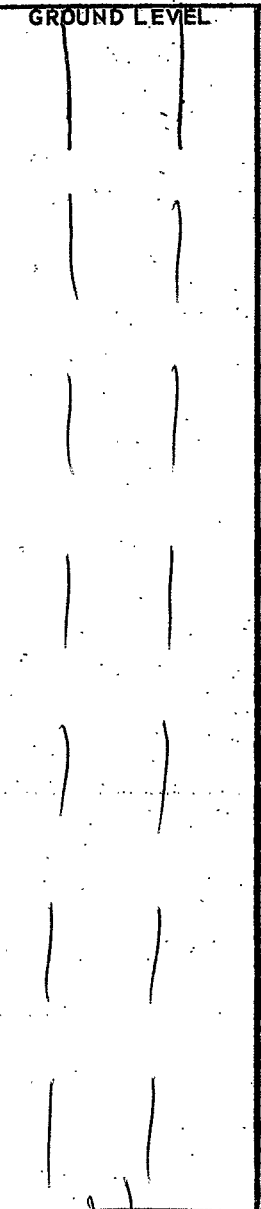


40'
4" casing

250'
2" casing

80 c.
Screen

If more than one screen, show locations of each on sketch.

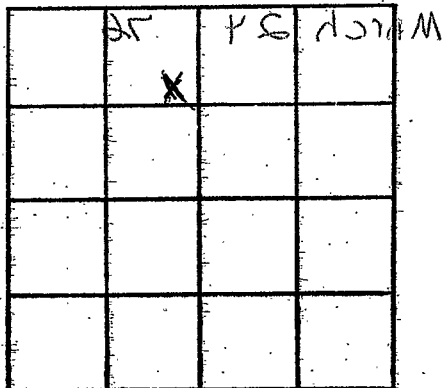

SECTION 28

Please indicate well location X.

ADDITIONAL INFORMATION

Multiple horizontal lines for additional information.