

LOWNDES

P 2001

6-28-76

MISSISSIPPI  
BOARD OF WATER COMMISSIONERS  
416 North State Street  
Jackson, Mississippi 39201

## WATER WELL DRILLERS LOG

June 28 1976 Abbasco Drilling Inc. Lowndes  
date well completed firm name county well located

LANDOWNER: Mr. Oscar Lee  
Boyd - Mrs. Ileana Boyd  
Rt. 1 Box 55  
Crawford, Ms. 39743  
(mailing address)

description of formations encountered

from

to

## WELL LOCATION:

sec. 19 T. 20N R. 18E  
17N5  
15 miles South of Columbus  
(distance) (direction) (nearest town)

WELL PURPOSE: home  
(home, irrigation, municipal, industrial)

## WELL COMPLETION DATA:

- (1) diameter (inches) 4" x 2"  
(2) total depth (feet) 490'  
(3) static water level (feet) 70 below  
top of ground. above  
(4) casing plastic, 20'  
(material) (depth)  
2"  
(size) if telescope see back.  
(5) screen 80', 410'  
(length) (depth to top)  
2", plastic  
(size) (material)  
(6) pump 1/2, 10  
(HP) (yield gpm)  
Electric  
(type power)  
(7) electric log NO  
(yes or no)

(organization running log)

(8) how well bottom plugged CAJ

DRILLERS REMARKS:


RECEIVED  
MAY 12 1976

MISS. BD.

If well telescopes please sketch and show depths.

GROUND LEVEL

20' 4"  
Casing

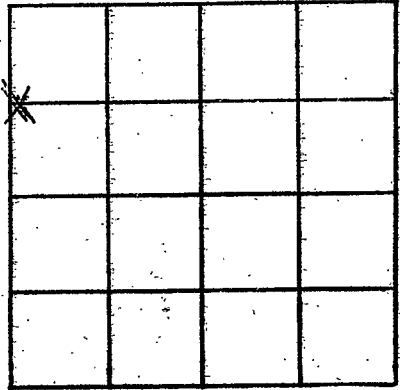

SECTION 19

Please indicate well location X.

ADDITIONAL INFORMATION

200' 2"  
Casing

80'  
Commercial  
Screen

If more than one screen, show locations of each on sketch.