

LOWDES
 P 7007
 3-9-77

MISSISSIPPI
 BOARD OF WATER COMMISSIONERS
 416 North State Street
 Jackson, Mississippi 39201

WATER WELL DRILLERS LOG

March 9 1977 ALLSUP Drilling Inc. LOWDES
 date well completed firm name county well located

LANDOWNER: MAR. MASON
Harris + son CHARLIE MASON
Rt 1 Box 100
Columbus, MS, 39701
 (mailing address)

description of formations encountered	from	to
Top Soil	0	10
Lime Rock	10	260
1st SAND	260	300
Muck	300	340
2nd SAND	340	500

WELL LOCATION:
 sec. 30 T. 10N R. 18E
10 miles (distance) E (direction) of Crawford (nearest town)

WELL PURPOSE: home
 (home, irrigation, municipal, industrial)

WELL COMPLETION DATA:

- (1) diameter (inches) 4" X 2"
- (2) total depth (feet) 500'
- (3) static water level (feet) 70 below top of ground. above
- (4) casing 4" plastic 37'
 (material) (depth)
- 4" X 2" (size) if telescope see back.
- (5) screen 80' 420'
 (length) (depth to top)
- 2" plastic
 (size) (material)
- (6) pump 1/2 10
 (HP) (yield gpm)
- Electric
 (type power)
- (7) electric log NO
 (yes or no)

(organization running log)

how well bottom plugged CAP

REMARKS:

RECEIVED

JUN - 6 1978

MISS. BD. OF WATER COMM

If well telescopes please sketch and show depths.


GROUND LEVEL

27'
4"
Casing

220'
2"
Casing

80'
Commercial
Screens

If more than one screen,
show locations of each on sketch.

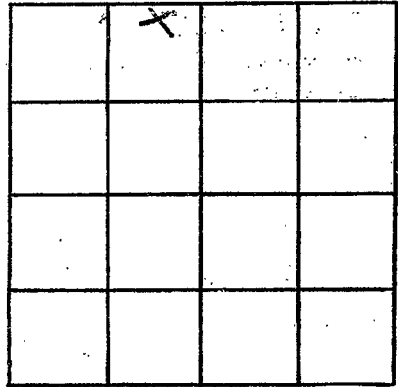

SECTION 30

Please indicate well location X.

ADDITIONAL INFORMATION

A series of horizontal lines provided for additional information.